


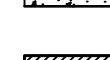
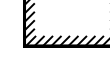


LEGEND:



-  GREEN SPACE
-  GRAVEL
-  ASPHALT
-  EXISTING COMMERCIAL CONSTRUCTION PER CITY OF BRYANT COMMERCIAL BUILDING REQUIREMENTS.
-  PROPOSED COMMERCIAL CONSTRUCTION PER CITY OF BRYANT COMMERCIAL BUILDING REQUIREMENTS.

CENTERLINE EXISTING COMMERCIAL DRIVEWAY

CENTERLINE EXISTING COMMERCIAL DRIVEWAY

CENTERLINE EXISTING ROAD

CENTERLINE EXISTING COMMERCIAL DRIVEWAY

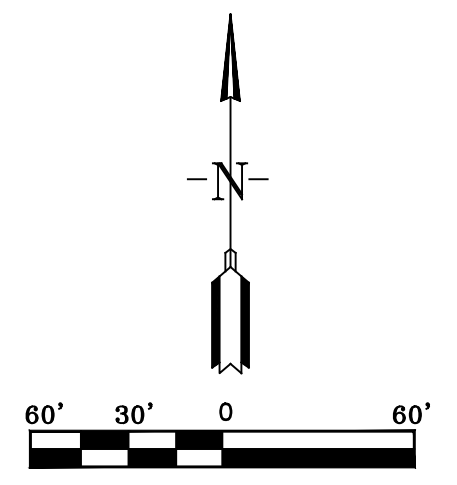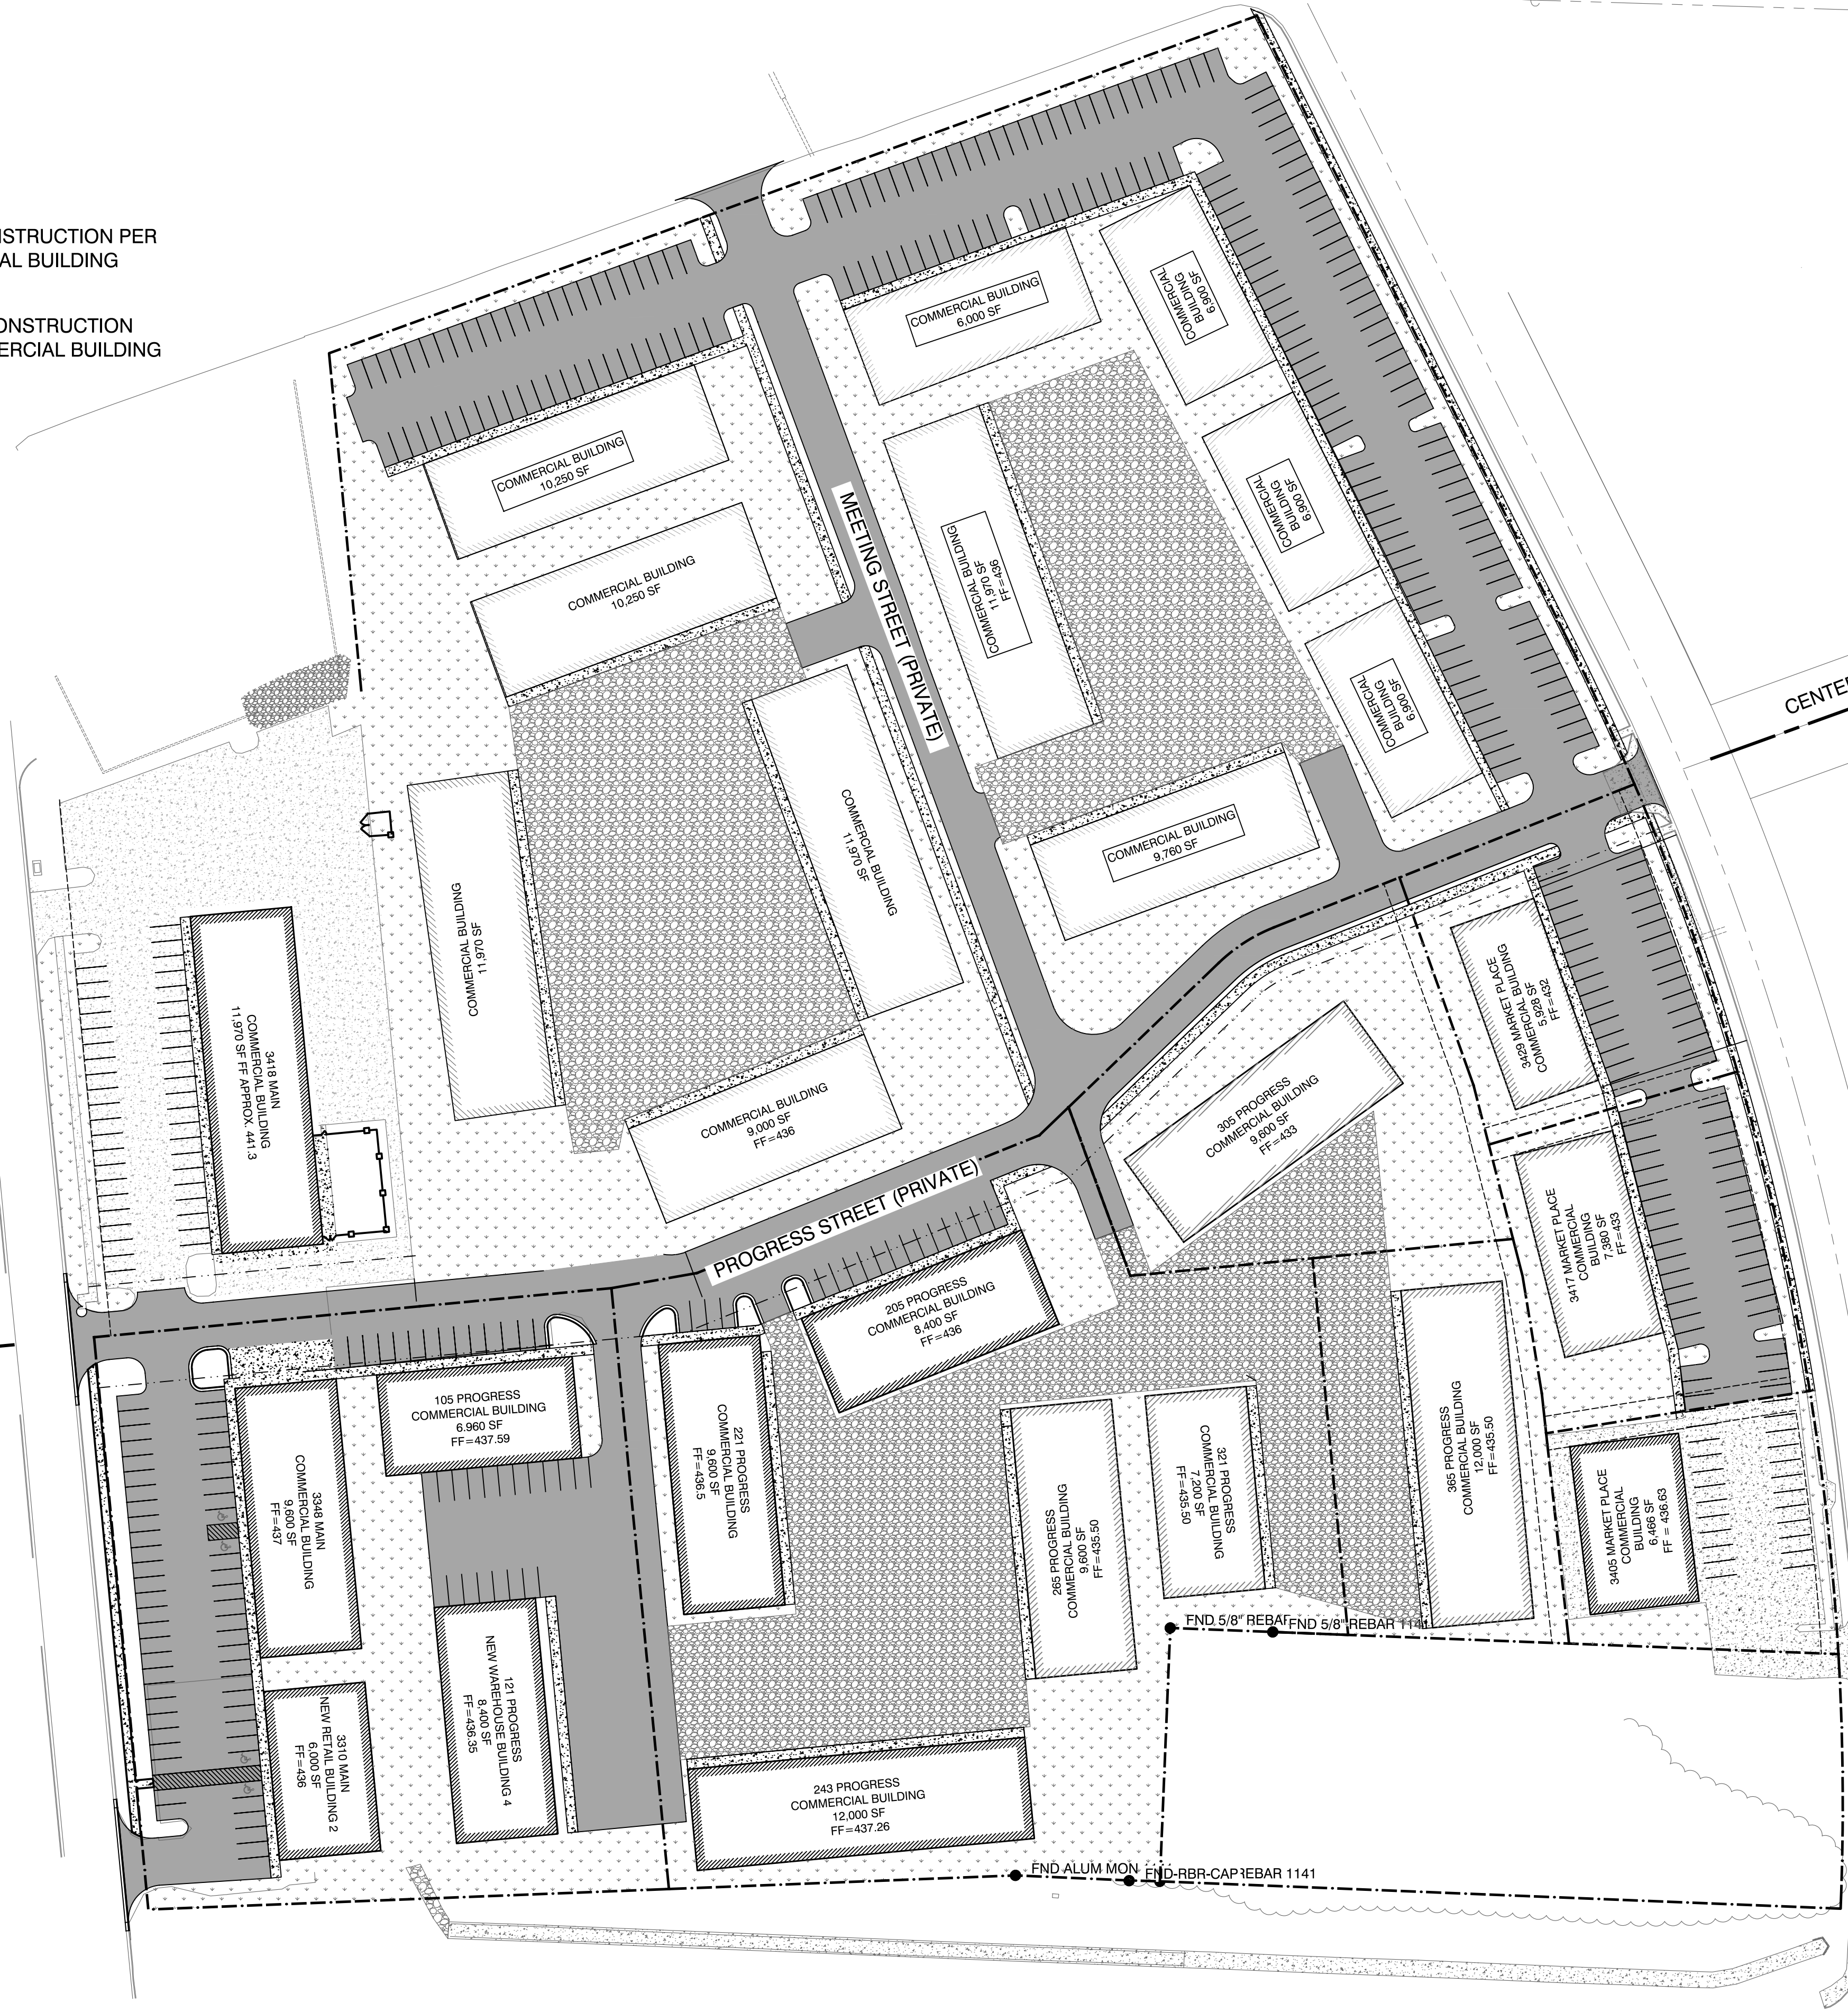

DATE	REVISION	BY
01-25-22	REVISED PER AS-BUILT	GPW

GNE Designing our client's success
GarNat Engineering, LLC
 P.O. Box 116
 Benton, AR 72018
 Ph: (501) 408-4650

3825 Mt Carmel Rd
 Bryant, AR 72022
 gnatengineering@gmail.com

MARKET PLACE CENTER
CITY OF BRYANT
SALINE COUNTY, ARKANSAS

PRELIMINARY

CONTENTS:
SCHEMATIC PLAN

PROJECT NO:
18087

DATE:
JANUARY 2022

SHEET NO:
N/A

J:\Projects\2018 Projects\18087_Bart_Engstrom - Market Place Center\Drawings\DWG\18087 - Schematic - 01-19-22-14.dwg