

CONSTRUCTION PLANS FOR

# GRACE VILLAGE SUBDIVISION - PHASE 3

## CITY OF BRYANT, SALINE COUNTY, ARKANSAS

REVISED AS CONSTRUCTED 7/20/22

Prepared by:  
**GarNat Engineering, LLC**


Designing our client's success

[www.garnatengineering.com](http://www.garnatengineering.com)


P.O. Box 116  
Benton, AR 72018  
Ph (501) 408-4650

**RECORD  
DRAWING**

3825 Mt Carmel Road  
Bryant, AR 72022  
Fx (888) 900-3068

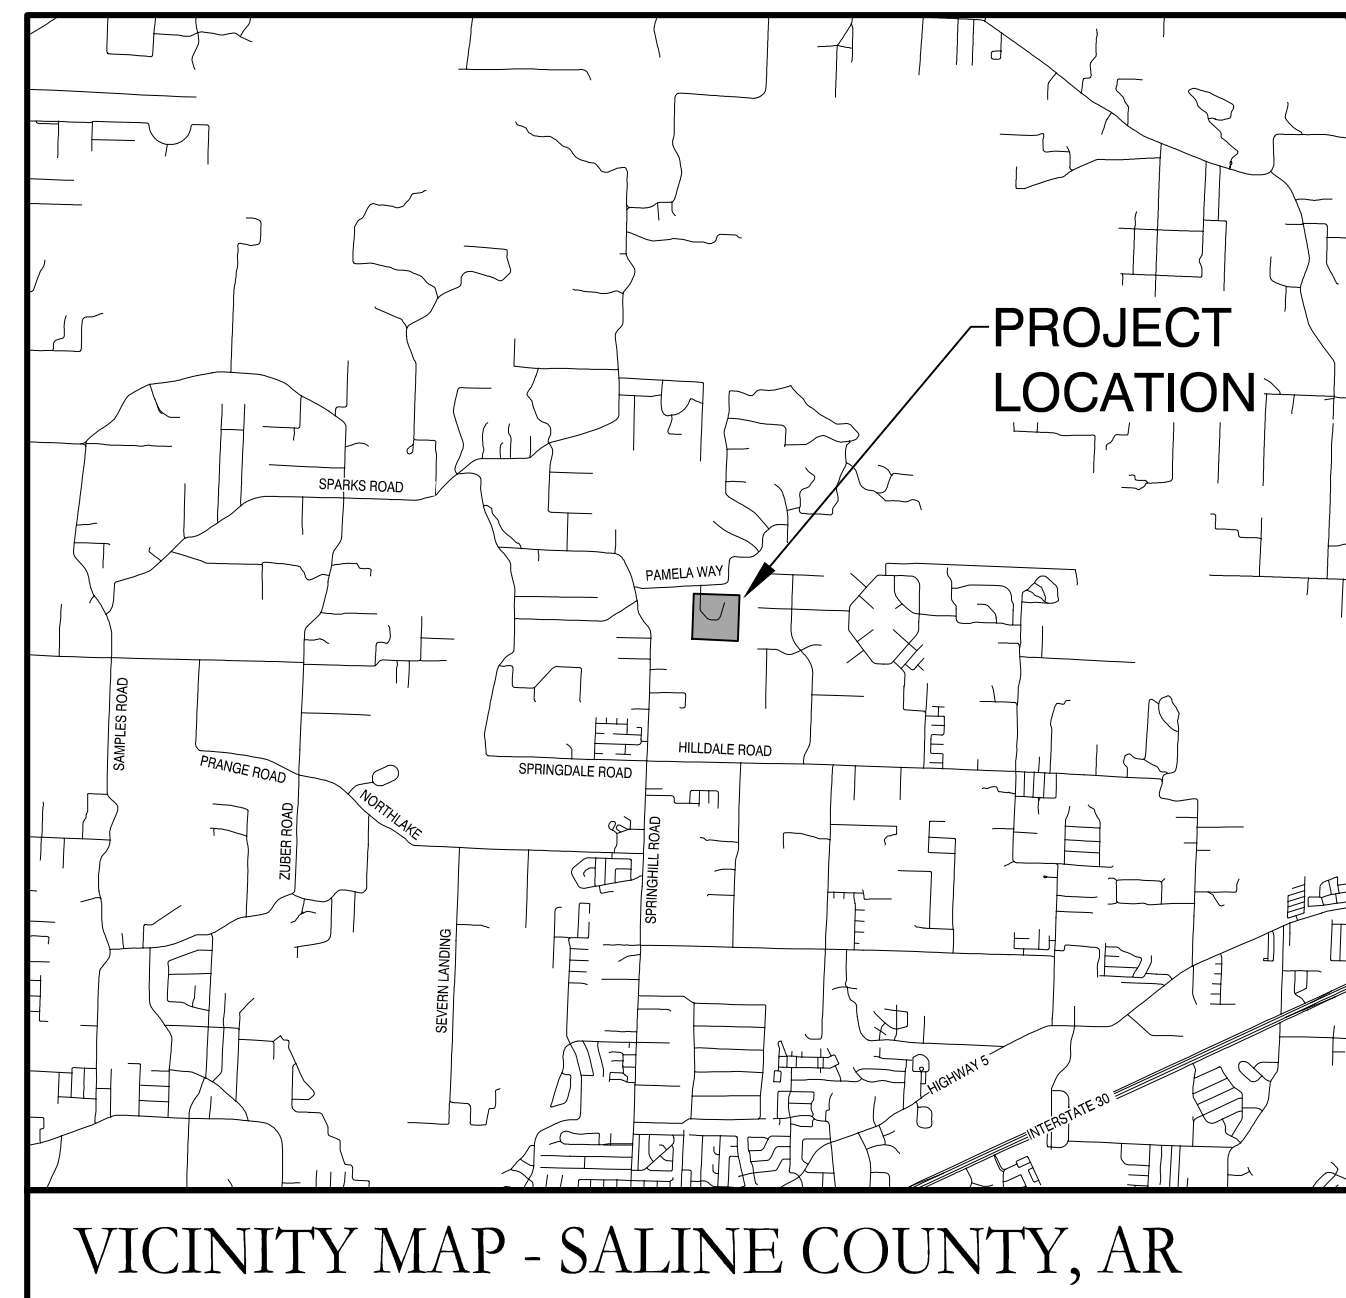

VICINITY MAP - SALINE COUNTY, AR

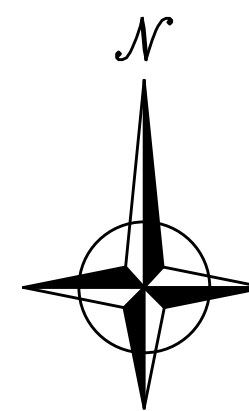

ARKANSAS

DRAWING INDEX:



- 1 FINAL PLAT
- 2 OVERALL WATER & SEWER PLAN
- 3 STREET & DRAINAGE PLAN
- 4 PEACE LANE PROFILE
- 5 KINDNESS COURT PROFILE
- 6 SANITARY SEWER PROFILE SSMH-1 TO SSMH-2
- 7 DRAINAGE PROFILES
- 8 SPILLWAY DETAILS



1-20-2021



Curve #	Length	Radius	Delta	Chord Direction	Chord Length
C3	45.27	50.00	51°52'21"	S79°41'37"E	43.74
C6	38.82	25.00	88°58'11"	S46°43'48"W	35.04
C7	46.60	25.00	106°48'37"	N35°22'48"W	40.14
C9	11.63	25.00	26°38'52"	N31°20'56"E	11.52
C10	52.20	50.00	59°49'00"	N14°45'52"E	49.86
C11	59.04	50.00	67°39'07"	N48°58'12"W	55.67
C12	69.17	50.00	79°16'01"	S57°34'14"W	63.79
C13	55.71	50.00	63°50'12"	S13°58'53"E	52.87
C14	27.89	25.00	63°55'29"	S13°56'14"E	26.47
C15	18.55	25.00	42°30'30"	S39°16'45"W	18.13
C16	59.62	50.00	68°19'24"	S26°22'19"W	56.15
C17	40.11	50.00	45°58'04"	S30°46'25"E	39.05
C18	22.40	50.00	25°39'48"	N61°32'18"E	22.21
C19	18.55	25.00	42°30'30"	N69°57'39"E	18.13
C20	39.72	25.00	91°02'15"	S43°15'59"E	35.67
C21	93.21	50.00	106°48'37"	S35°22'48"E	80.29

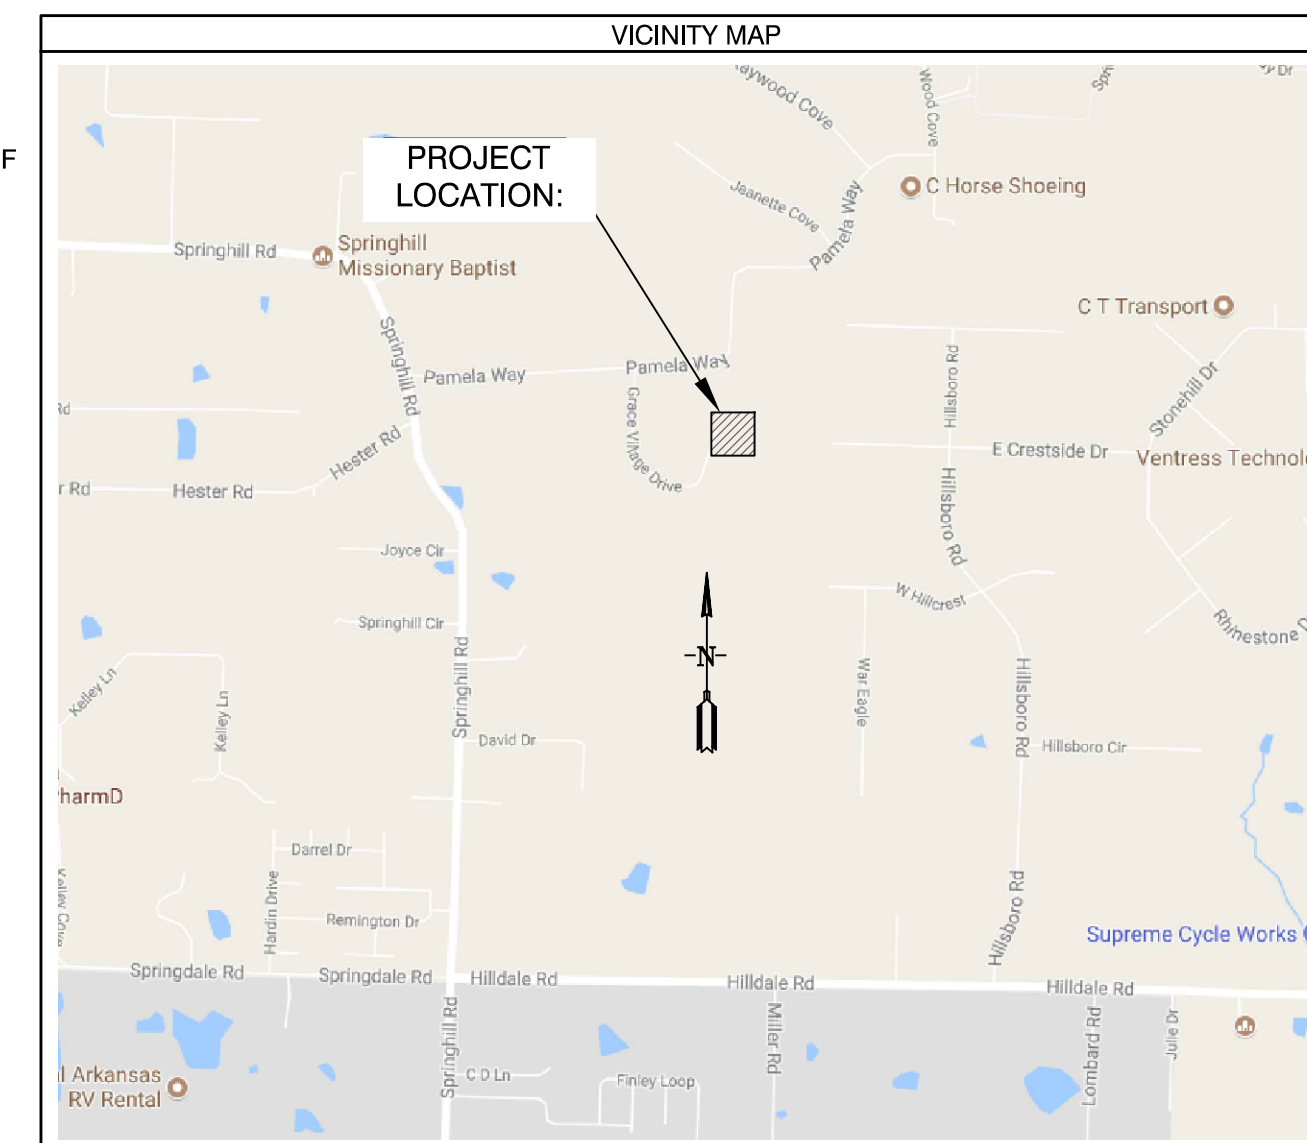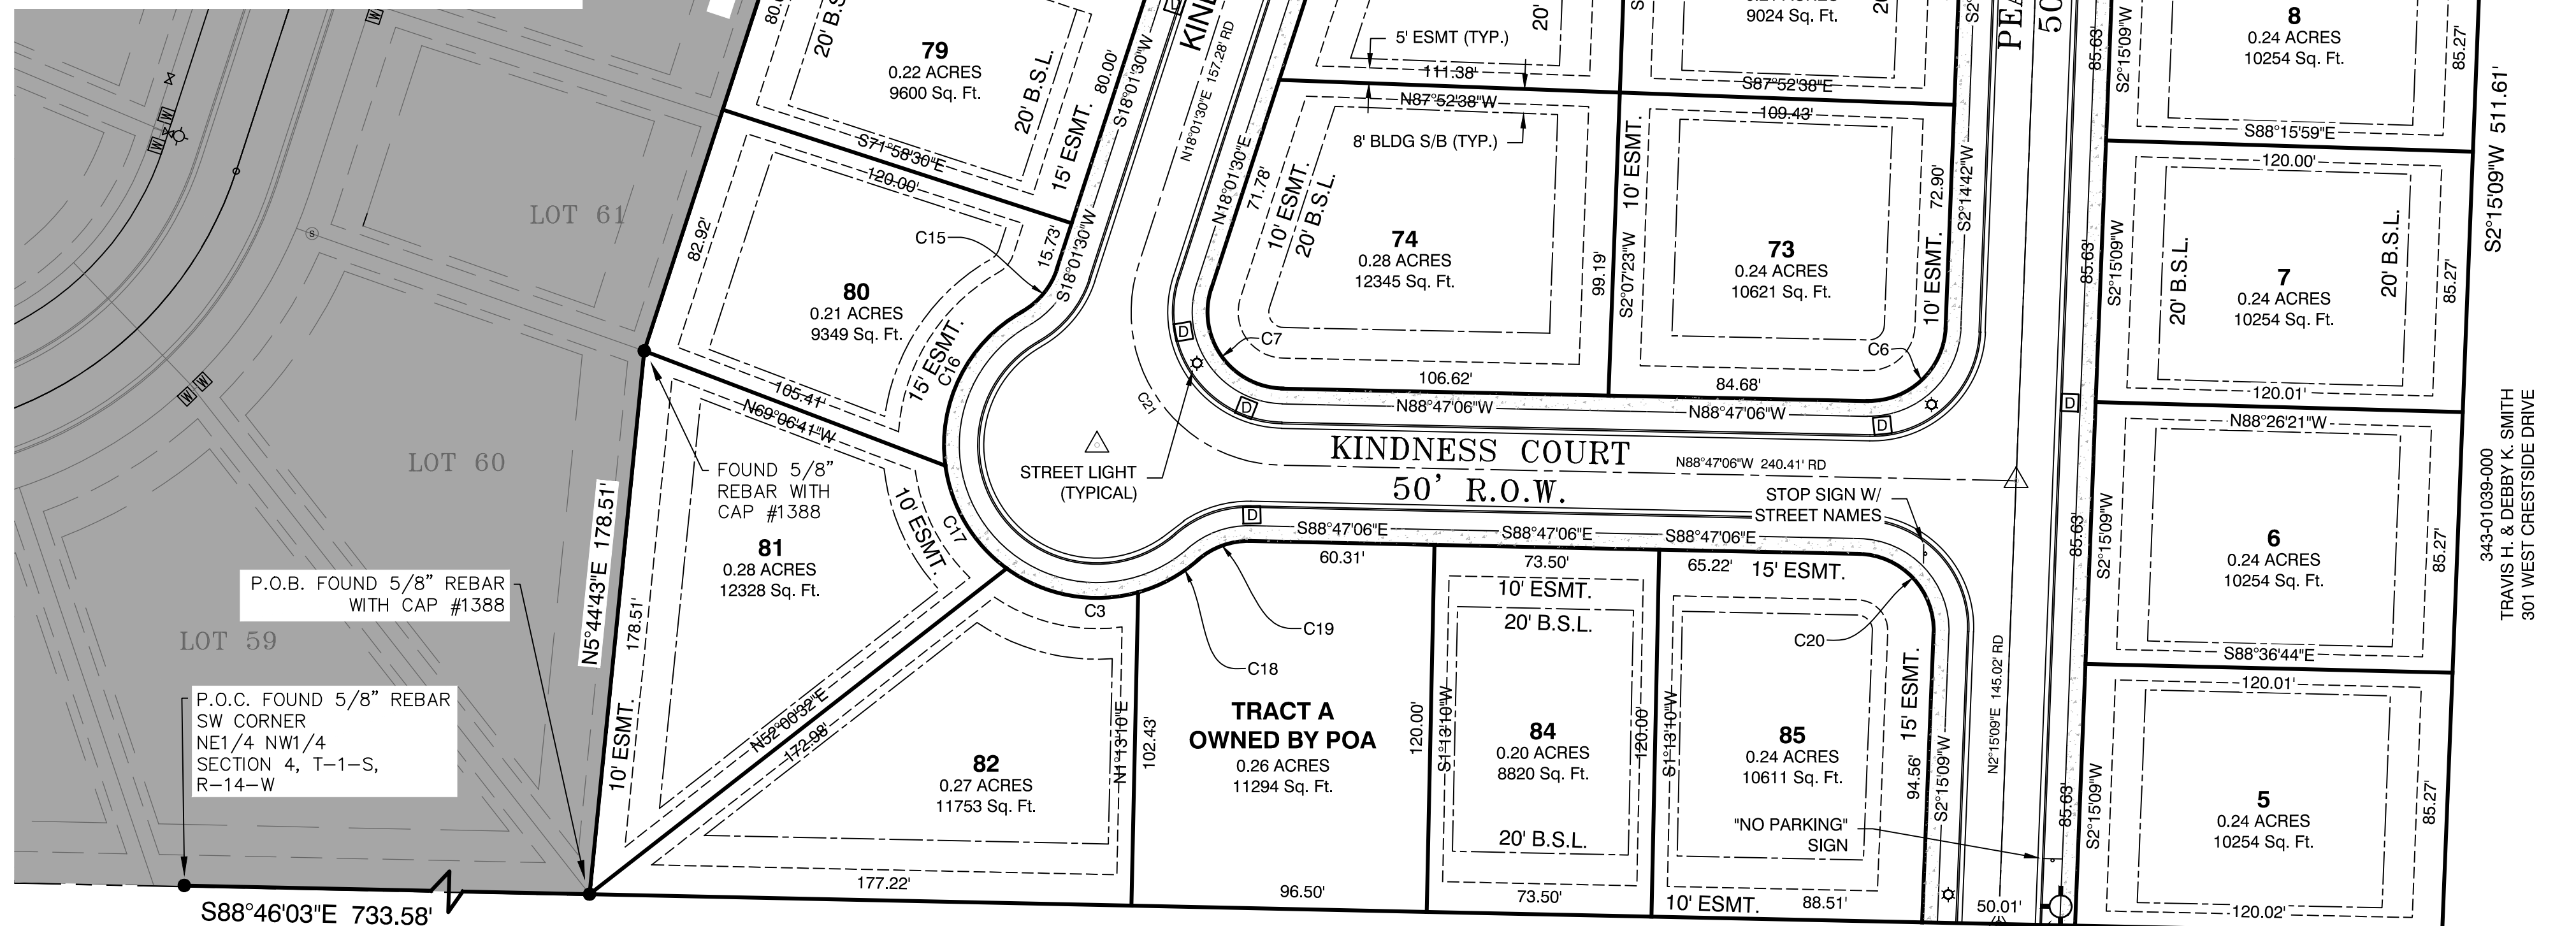

**BASIS OF BEARINGS:**  
NAD 83 ARKANSAS GRID SOUTH ZONE (GPS)

**CERTIFICATIONS:**  
By affixing my seal and signature, I George P. Wooden, PLS No. 1573, hereby certify that this drawing correctly depicts a survey compiled under my supervision dated January 15, 2021.

According to the Federal Emergency Management Agency (FEMA) Flood Insurance Rate Map (FIRM) for Saline County unincorporated areas, panel # 05125C0222E dated 6/5/2020, no portion of the property described hereon does lie within the 100 year flood hazard boundary.


**PROPERTY SPECIFICATIONS:**  
ZONING CLASSIFICATION: R-1.5  
MIN. LOT SIZE: 8,630 S.F.  
NUMBER OF LOTS: 22  
SOURCE OF WATER: SALEM WATER  
SOURCE OF SEWER: CITY OF BRYANT

**BUILDING SETBACKS:**  
FRONT - 20' OR AS SHOWN  
REAR - 20' OR AS SHOWN  
SIDE - 8' OR AS SHOWN

**EASEMENTS: UTILITY & DRAINAGE (D.E. & U.E.)**  
FRONT - 10' OR AS SHOWN  
REAR - 10' OR AS SHOWN  
SIDE - 9' OR AS SHOWN  
STREET RIGHT OF WAY: 50' OR AS SHOWN  
STREET WIDTH: 30' BOC TO BOC  
LOT CORNERS: SET #4 REBAR WITH CAP

**SURVEY LEGEND**  
 (A) - Computed point  
 (B) - Found monument  
 (C) - Set #4 RB/Plas. Cap  
 (M) - Measured  
 (R) - Record  
 (P) - Platted

**GENERAL NOTES:**  
 1. ALL STREETS & DRAINAGE TO MEET CITY OF BRYANT STANDARD SPECIFICATIONS & DETAILS.  
 2. ALL TRAFFIC CONTROL DEVICES SHALL MEET THE REQUIREMENTS OF CITY OF BRYANT STANDARD SPECIFICATIONS PER PART 4.9  
 3. NO FENCES CAN BE CONSTRUCTED IN DRAINAGE EASEMENTS WHERE OPEN DITCHES EXIST.  
 4. ROADS WILL BE MAINTAINED, INSPECTED, & ACCEPTED BY SALINE COUNTY.  
 5. NO FENCES SHALL BE BUILT WITHIN DRAINAGE EASEMENTS.  
 6. NO POOLS OR PERMANENT STRUCTURES SHALL BE BUILT IN EASEMENTS.  
 7. NO FENCES SHALL BE BUILT IN ROAD RIGHT-OF-WAY OR ACCESS EASEMENTS.

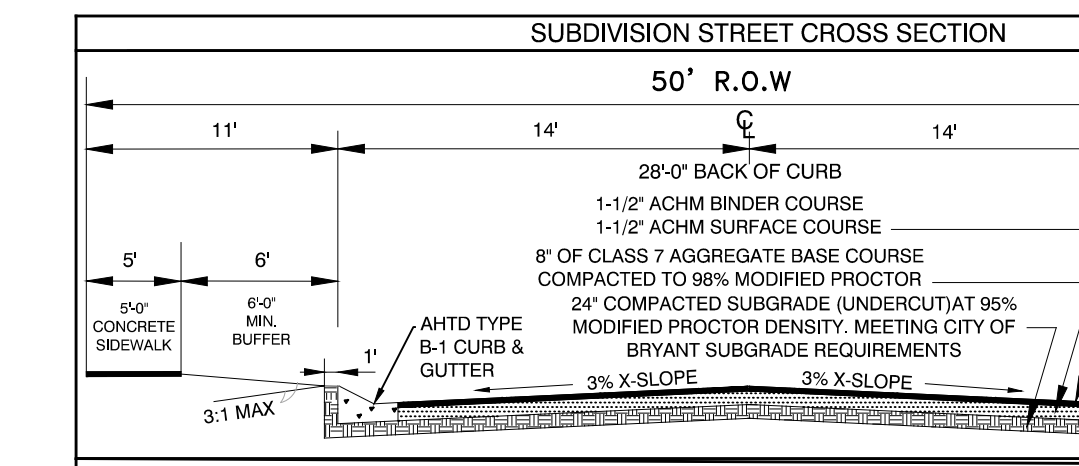

**PROPERTY DESCRIPTION:**  
 GRACE VILLAGE PHASE 3 LEGAL DESCRIPTION:  
 PART OF THE NORTHEAST QUARTER OF THE NORTHWEST QUARTER (NE1/4 NW1/4) OF SECTION 4, TOWNSHIP 01 SOUTH, RANGE 14 WEST, IN SALINE COUNTY, ARKANSAS, BEING MORE PARTICULARLY DESCRIBED AS FOLLOWS:  
 COMMENCING AT THE SOUTHWEST CORNER OF SAID NORTHEAST QUARTER OF THE NORTHWEST QUARTER OF SECTION 4, BEING A FOUND 5/8" REBAR; THENCE S88°46'03"E A DISTANCE OF 733.58 FEET TO A FOUND 5/8" REBAR WITH CAP #1388 FOR THE POINT OF BEGINNING; THENCE N5°44'43"E A DISTANCE OF 178.51 FEET TO A FOUND 5/8" REBAR WITH CAP #1388; THENCE N18°01'30"E A DISTANCE OF 307.92 FEET TO A FOUND 5/8" REBAR WITH CAP #1388 AT THE SOUTHWEST CORNER OF LOT 65 OF GRACE VILLAGE PHASE 2; THENCE N13°36'45"E, ALONG SAID EAST LINE OF GRACE VILLAGE PHASE 2, A DISTANCE OF 48.27 FEET TO A FOUND 1/2" REBAR WITH CAP #1573 AT THE NORTHEAST CORNER OF LOT 65 AND THE SOUTHWEST CORNER OF LOT 66 OF GRACE VILLAGE SUBDIVISION PHASE 2B; THENCE S87°52'37"E, ALONG THE SOUTH LINE OF SAID PHASE 2B, 331.54 FEET TO A FOUND 1/2" REBAR WITH CAP #1573; THENCE S87°44'51"E, CONTINUING ALONG SOUTH LINE OF SAID PHASE 2B, 170.04 FEET TO A FOUND 1/2" REBAR WITH CAP #1573 LOCATED ON THE WEST LINE OF LOT 39 OF THE HILLS PHASE 5; THENCE S2°15'09"W, ALONG SAID WEST LINE OF THE HILLS PHASE 5, A DISTANCE OF 511.61 FEET TO A FOUND DRILL STEM IN A STONE COLLAR AT THE SOUTHWEST CORNER OF THE SAID NORTHEAST QUARTER OF THE NORTHWEST QUARTER OF SECTION 4; THENCE N88°47'06"W, ALONG THE SOUTH LINE OF THE SAID NORTHEAST QUARTER OF THE NORTHWEST QUARTER, A DISTANCE OF 605.76 FEET TO THE POINT OF BEGINNING; CONTAINING 291,688 SQUARE FEET (6.70 ACRES), MORE OR LESS.

**PLAT CERTIFICATES:**

**OWNER:**  
 Name: James H. Brown  
 Address: Broken Bow Development, Inc., #9 Mountain View Court, Little Rock, Arkansas 72212

**DEVELOPER:**  
 Name: James H. Brown  
 Address: Broken Bow Development, Inc., #9 Mountain View Court, Little Rock, Arkansas 72212

**CERTIFICATE OF OWNER:**  
 We, the undersigned, owners of the real estate shown and described herein do hereby certify that we have laid off, platted and subdivided, and do hereby lay off, plat and subdivide said real estate in accordance with the within plat.

Date: \_\_\_\_\_ Signed: \_\_\_\_\_  
 Name: James H. Brown  
 Address: #9 Mountain View Court, Little Rock, Arkansas 72212

Source of Title Saline County: Deed Book 2009, Page 101708

**CERTIFICATE OF ENGINEERING ACCURACY:**  
 I, Vernon J. Williams, hereby certify that this plat correctly represents a survey and a plan made by me or under my supervision; that all monuments shown hereon actually exist and their locations, size, type, and material are correctly shown; and that all requirements of the City of Bryant Subdivision Rules and Regulations have been fully complied with.

Date: \_\_\_\_\_ Signed: \_\_\_\_\_  
 Name: Vernon J. Williams  
 Address: Registered Professional Engineer No. 9551, Arkansas

**CERTIFICATE OF SURVEYING ACCURACY:**  
 I, George P. Wooden, hereby certify that this final plat correctly represents a boundary survey made by me or under my supervision; that the boundary lines shown hereon correspond with the description in the deeds cited in the above Source of Title; and that all monuments which were found or placed on the property are correctly described and located.

Date: \_\_\_\_\_ Signed: \_\_\_\_\_  
 Name: George P. Wooden  
 Address: Registered Land Surveyor No. 1573, Arkansas

**CERTIFICATE OF FINAL PLAT APPROVAL:**  
 Pursuant to the City of Bryant Subdivision Rules and Regulations, this document was given approval by the Bryant Planning Commission. All of the document is hereby accepted, and this certificate executed under the authority of said rules and regulations.

Date: \_\_\_\_\_ Signed: \_\_\_\_\_  
 Name: Rick Johnson, Chairman  
 Address: Bryant Planning Commission

**FINAL PLAT  
 GRACE VILLAGE SUBDIVISION  
 PHASE 3  
 SALINE COUNTY, ARKANSAS**




BY	REVISION	DATE	1. REVISED PER CITY OF BRYANT.
ATV		2/11/21	
GPW		2/25/21	2. REVISED PER CITY OF BRYANT.

**GNE** Designing our client's success  
**GarNat Engineering, LLC**  
 3825 Mt Carmel Road  
 Bryant, AR 72022  
 P.O. Box 116  
 Benton, AR 72018  
 Ph: (501) 408-4650  
 gnatengineering@gmail.com

GRACE VILLAGE SUBDIVISION  
 PHASE 3  
 CITY OF BRYANT,  
 SALINE COUNTY, ARKANSAS


**FINAL PLAT**

PROJECT NO: 16072  
 DATE: MAY 18, 2022  
 SHEET NO: 1

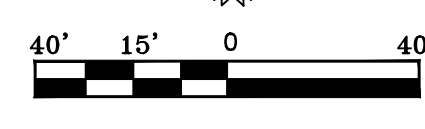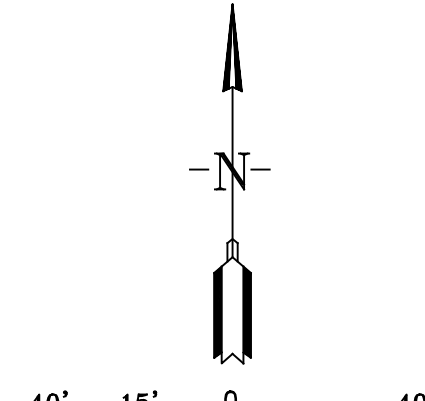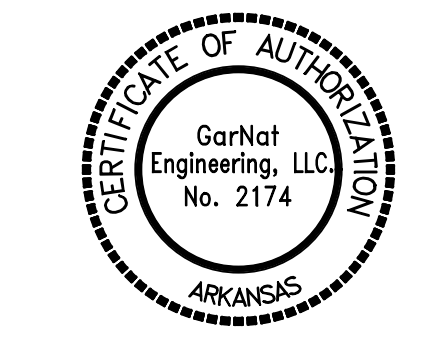



- NOTES:
- BURIED UTILITIES ARE LOCATED AT THE SITE. CONTACT ARKANSAS ONE CALL & WHERE APPROPRIATE THE UTILITY COMPANIES PRIOR TO DIGGING.
  - ALL UNRESTRAINED WATER LINE FITTINGS SHALL BE INSTALLED WITH A CONCRETE THRUST BLOCK FOR JOINT RESTRAINT.
  - WORK ON EXISTING ROADS SHALL INCLUDE WARNING SIGNS & BARRICADES IN ACCORDANCE WITH THE REQUIREMENTS OF THE STATE, COUNTY, OR CITY HAVING JURISDICTION. OTHER SIGNS & DEVICES, SUCH AS PLATING, SHALL BE PLACED AS REQUIRED TO ADEQUATELY PROTECT THE PUBLIC.
  - ALL SEWER LINE CONSTRUCTION SHALL COMPLY WITH CITY OF BRYANT STANDARD SPECIFICATIONS & DETAILS.
  - ALL WATER LINE CONSTRUCTION SHALL COMPLY WITH SALEM WATER USERS STANDARD SPECIFICATIONS & DETAILS.
  - MAINTAIN 10 FEET OF HORIZONTAL SEPARATION BETWEEN WATER & SEWER LINES.
  - ALL UTILITIES THAT WILL BE LOCATED UNDER PAVEMENT SHALL BE BACKFILLED IN ACCORDANCE WITH THE BRYANT STREET SPECIFICATIONS AND BRYANT WATER & SEWER STANDARD SPECIFICATIONS.
  - TELEPHONE, ELECTRICAL, AND OTHER BURIED UTILITIES ARE TO BE A MINIMUM OF 3-FEET HORIZONTALLY FROM INSTALLED WATER AND SEWER LINES.

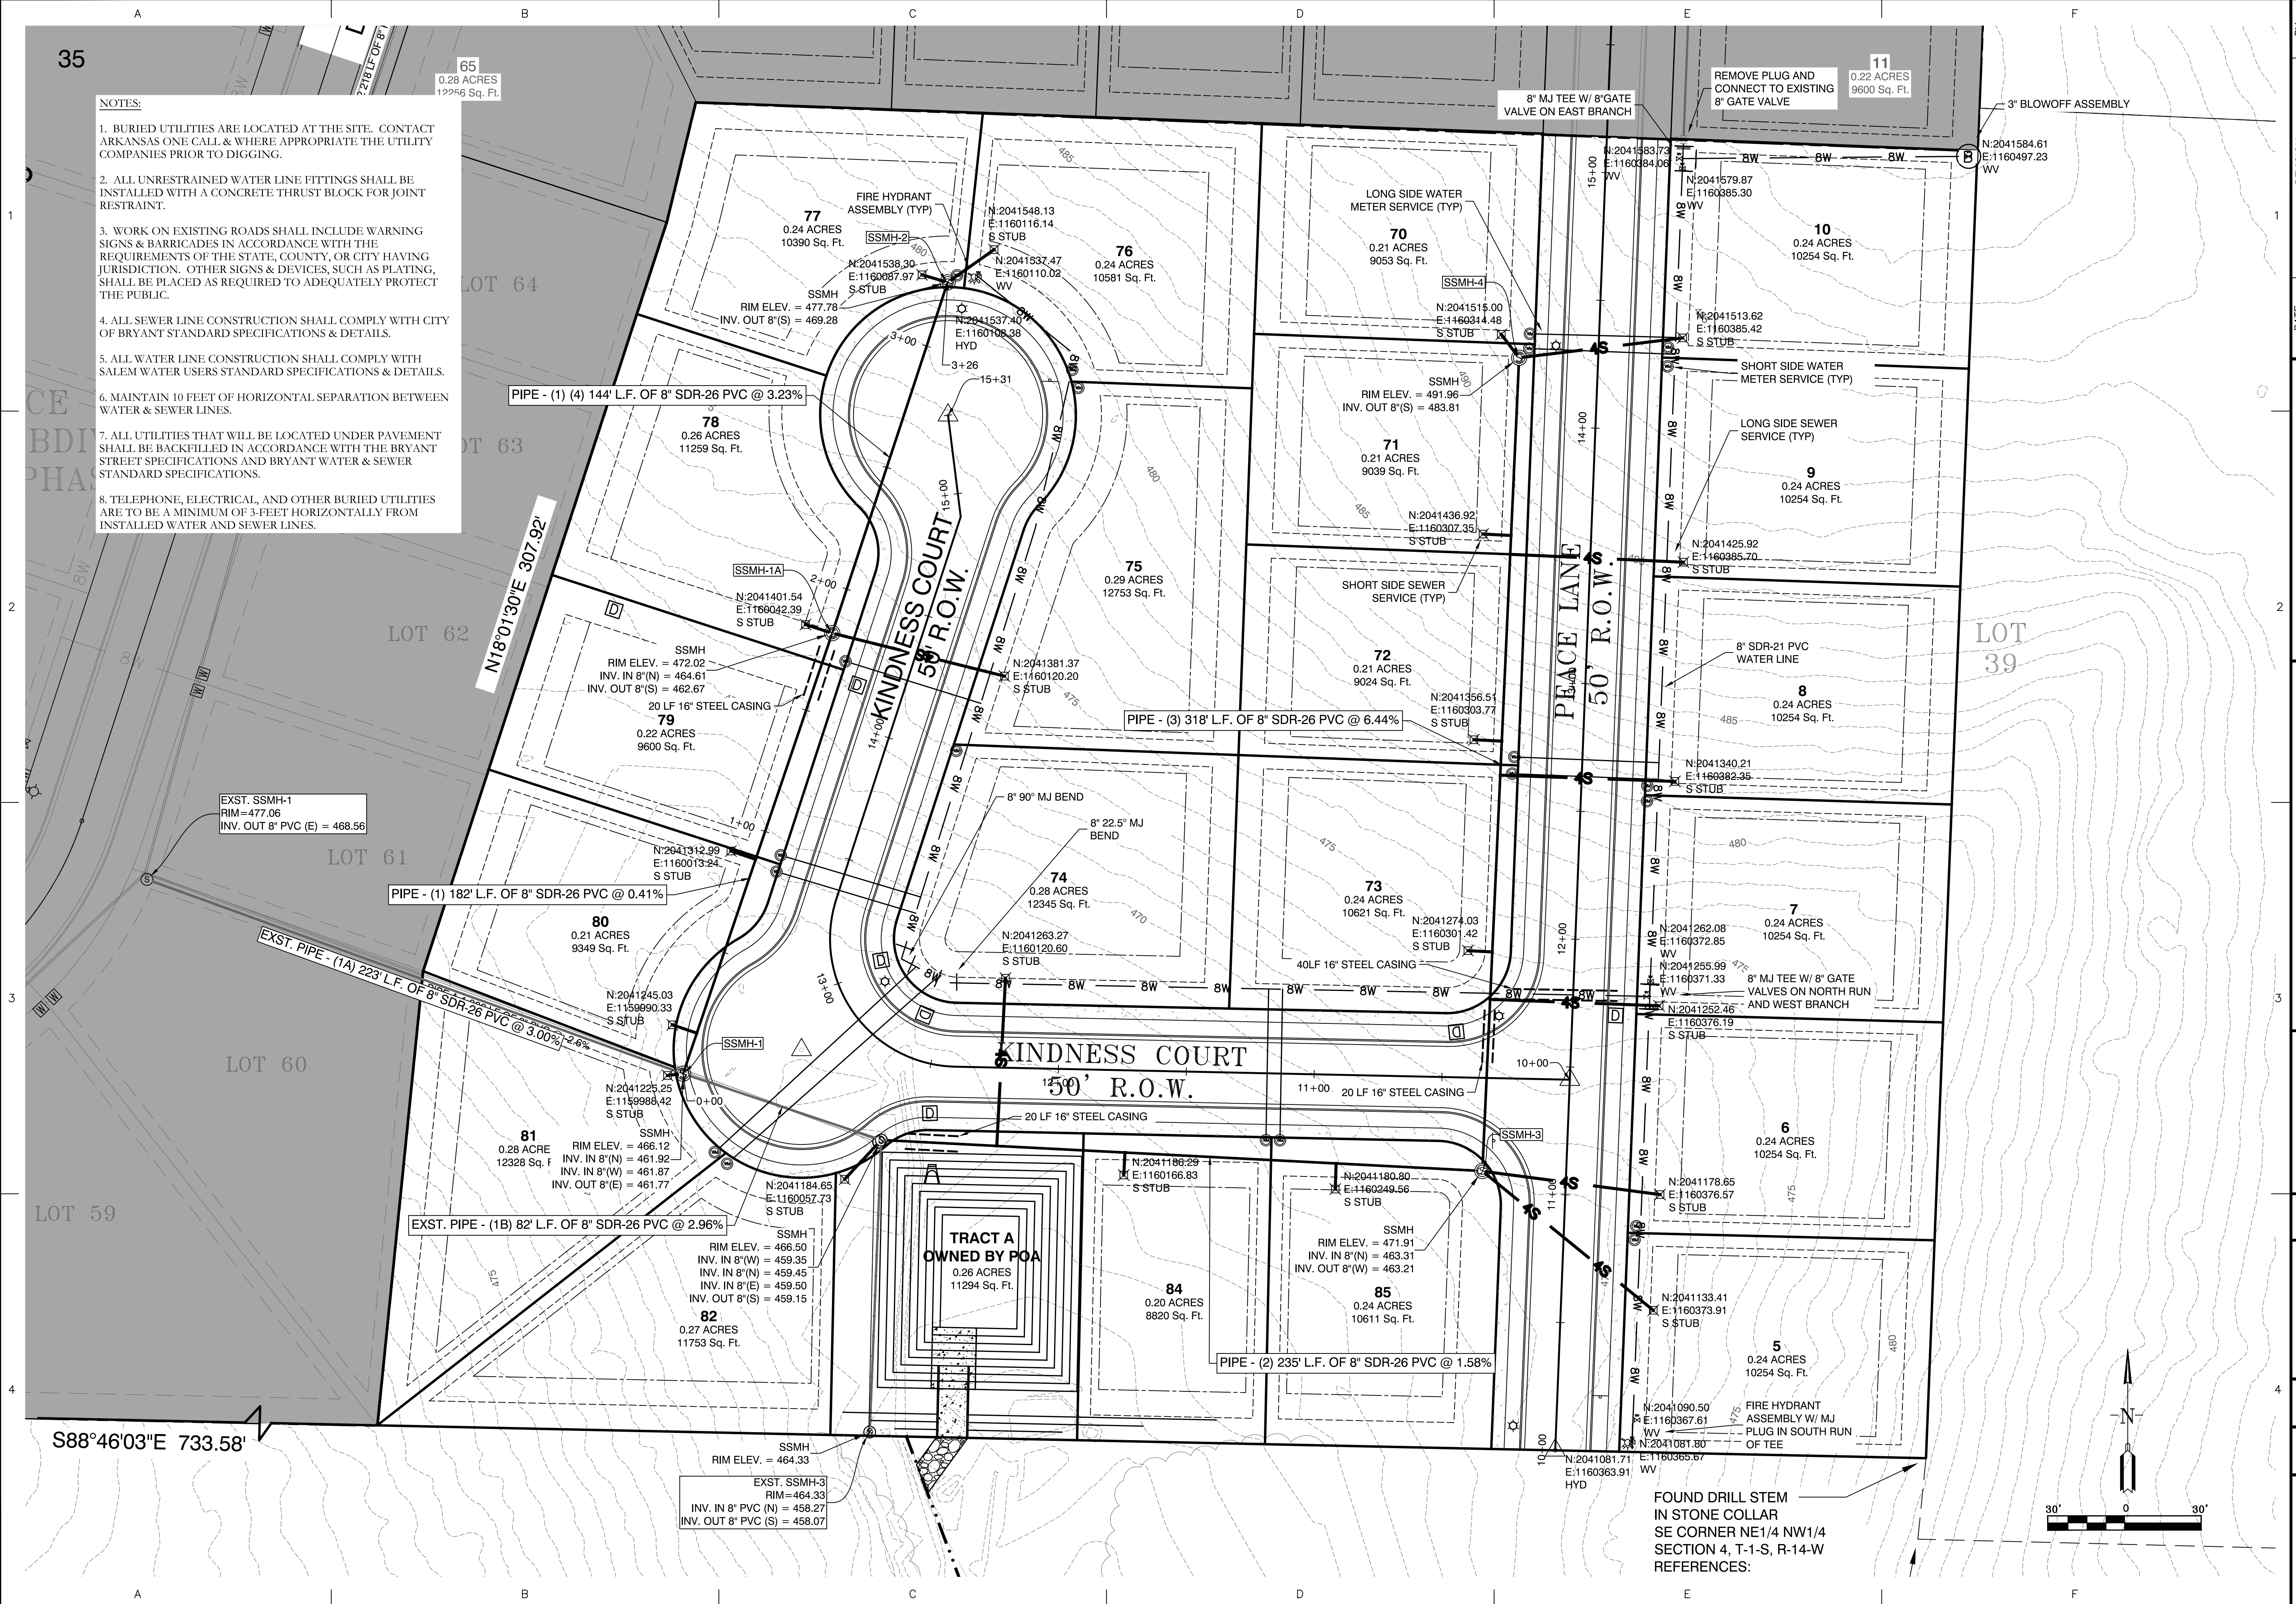

BY	REVISION	DATE
GPW	2. REVISED PER CITY OF BRYANT.	2/25/21

**GN** Designing our client's success  
**GarNat Engineering, LLC**  
 3825 Mt. Carmel Rd  
 Bryant, AR 72022  
 P.O. Box 116  
 Benton, AR 72018  
 Phone: (501) 408-4650  
 Email: gnatengineering@gmail.com



GRACE VILLAGE SUBDIVISION  
 PHASE 3  
 CITY OF BRYANT,  
 SALINE COUNTY, ARKANSAS

**RECORD  
 DRAWING**

CONTENTS:  
 OVERALL  
 WATER &  
 SEWER PLAN

PROJECT NO:  
 16072  
 DATE:  
 JAN, 2021  
 SHEET NO:



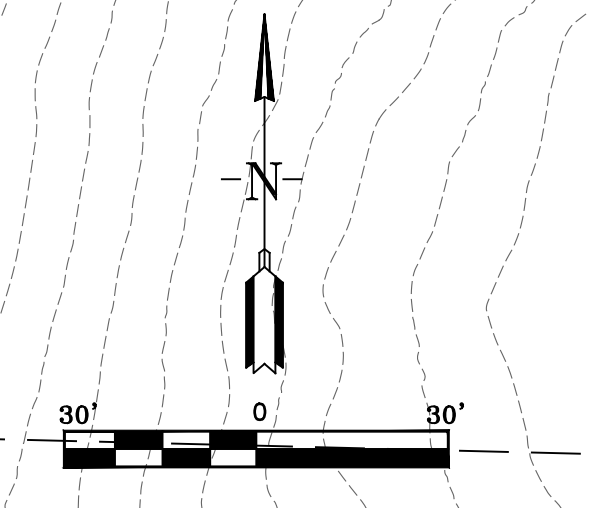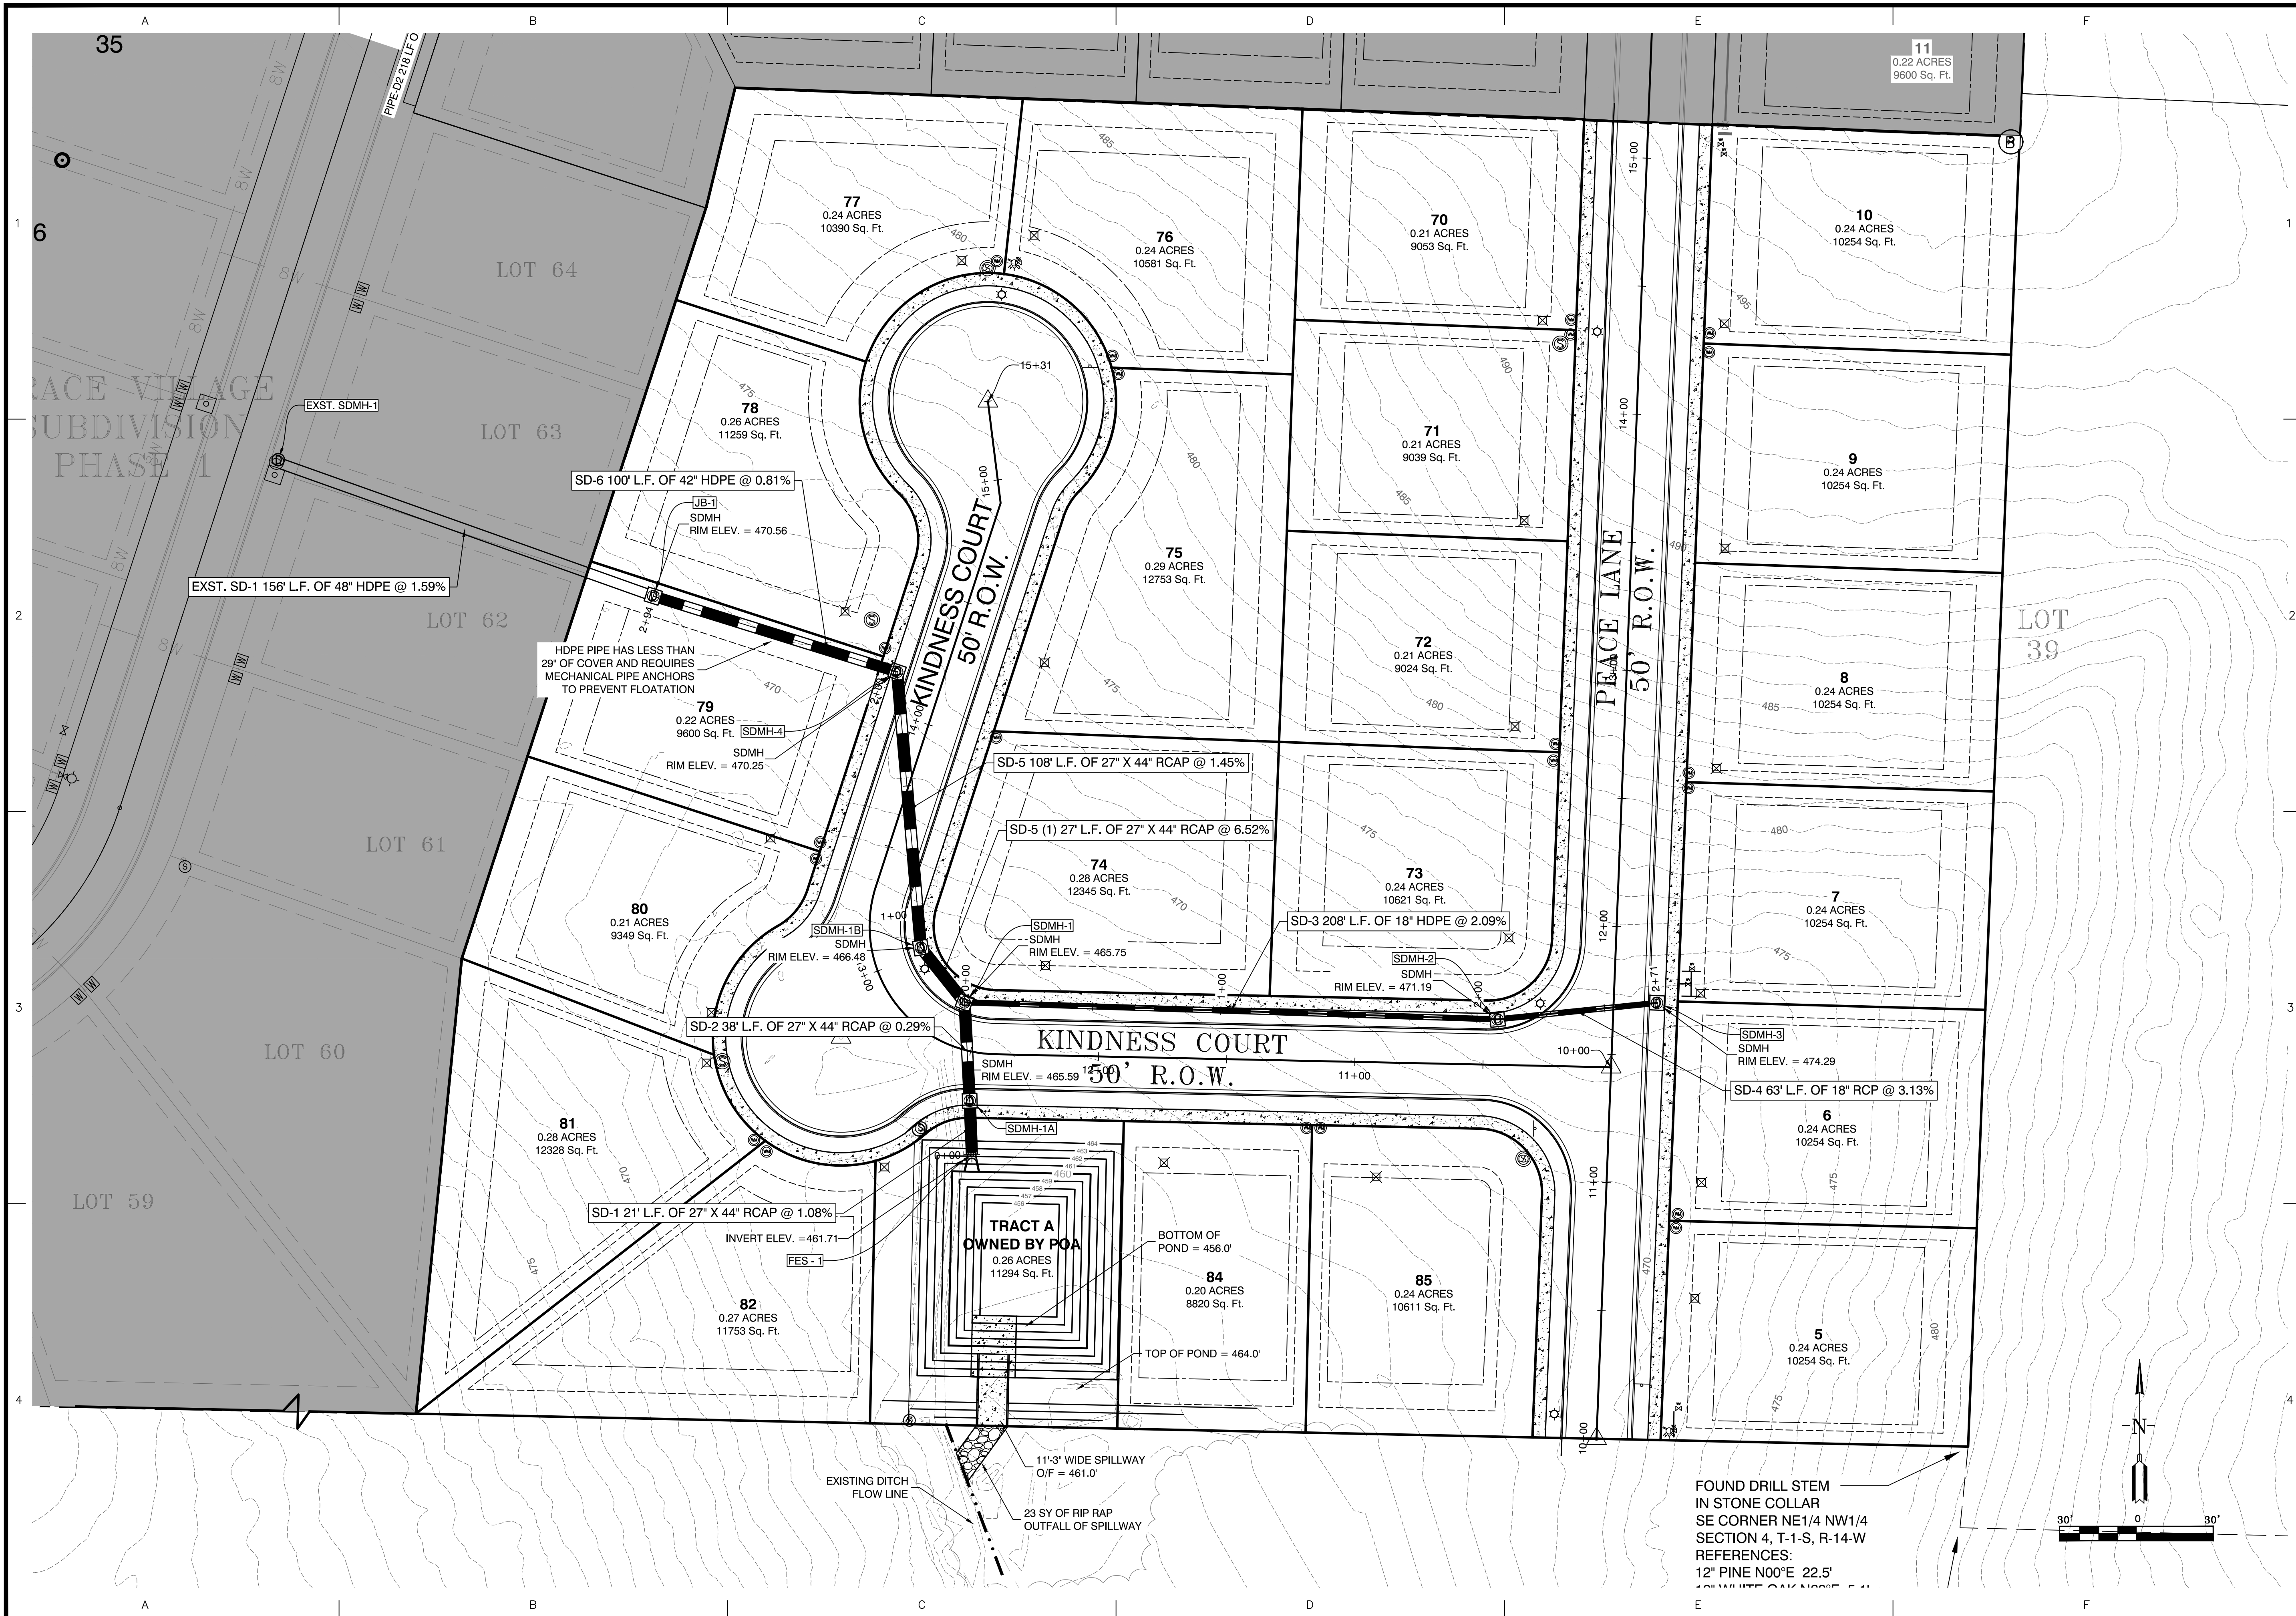


FOUND DRILL STEM  
IN STONE COLLAR  
SE CORNER NE1/4 NW1/4  
SECTION 4, T-1-S, R-14-W  
REFERENCES:  
12" PINE N00°E 22.5'  
10" WHITE OAK 10225 5 41

BY	ATV	
	GPW	
REVISION	1. REVISED PER CITY OF BRYANT.	
	2. REVISED PER CITY OF BRYANT.	
DATE	2/11/21	
	2/25/21	
<p><b>GNE</b> Designing our client's success  <b>GarNat Engineering, LLC</b>          P.O. Box 116          Benton, AR 72018          Ph. (501) 408-4650          garnatengineering@gmail.com</p>		
<p>GRACE VILLAGE SUBDIVISION          PHASE 3          CITY OF BRYANT,          SALINE COUNTY, ARKANSAS</p>		
<p><b>RECORD DRAWING</b></p>		
<p>CONTENTS:  <b>STREET &amp; DRAINAGE PLAN</b></p>		
PROJECT NO:	16072	
DATE:	JAN, 2021	
SHEET NO:	<p><b>3</b></p>	



PEACE LANE PROFILE

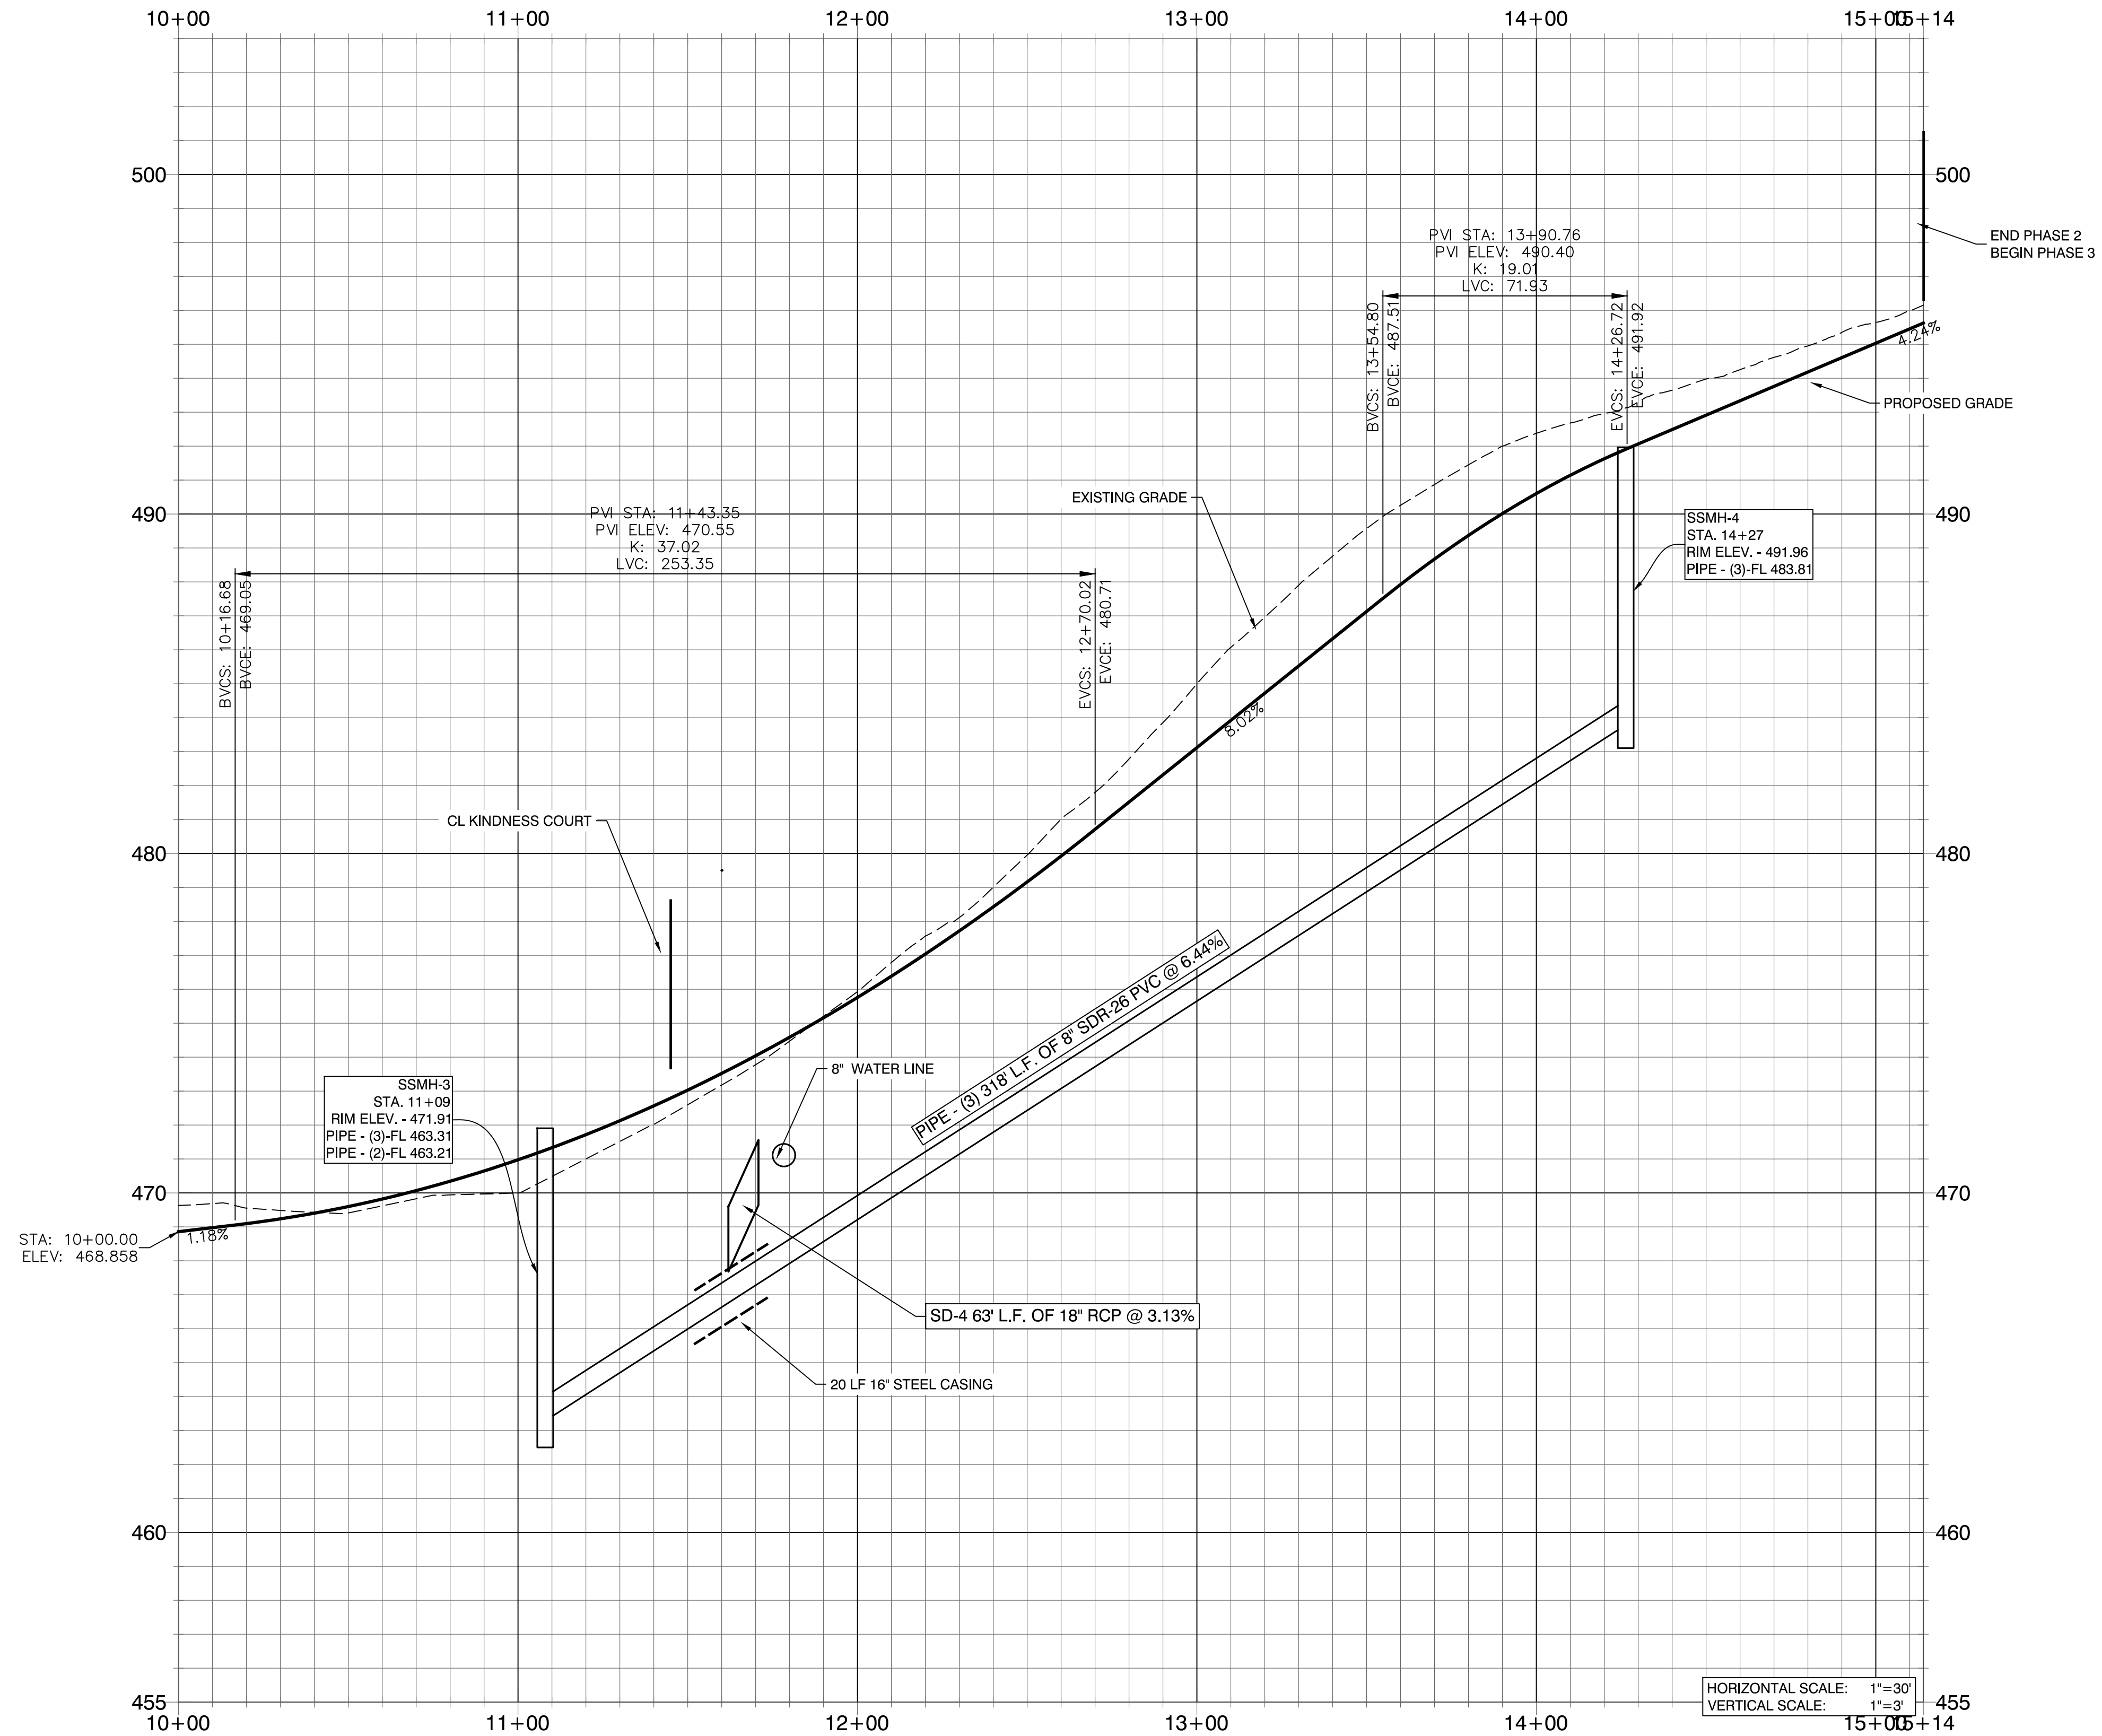

HORIZONTAL SCALE: 1"=30'  
VERTICAL SCALE: 1"=3'



REVISION	DATE	BY

**GNE** Designing our client's success  
**GarNat Engineering, LLC**  
 3825 Mt. Carmel Rd  
 Bryant, AR 72022  
 P.O. Box 116  
 Benton, AR 72018  
 Ph: (501) 408-4650  
 gnatengineering@gmail.com

GRACE VILLAGE SUBDIVISION  
 PHASE 3  
 CITY OF BRYANT,  
 SALINE COUNTY, ARKANSAS

**RECORD  
 DRAWING**

CONTENTS:  
 PEACE LANE  
 PROFILE

PROJECT NO:  
 16072


DATE:  
 JAN, 2021

SHEET NO:  
 4

A:\Projects\2018 Projects\16072 Grace Village Phase 3\Drawings\DWG\PEACE\_LANE\_PROFILE\_3\_ISSUE-REV-071822.dwg



KINDNESS COURT PROFILE

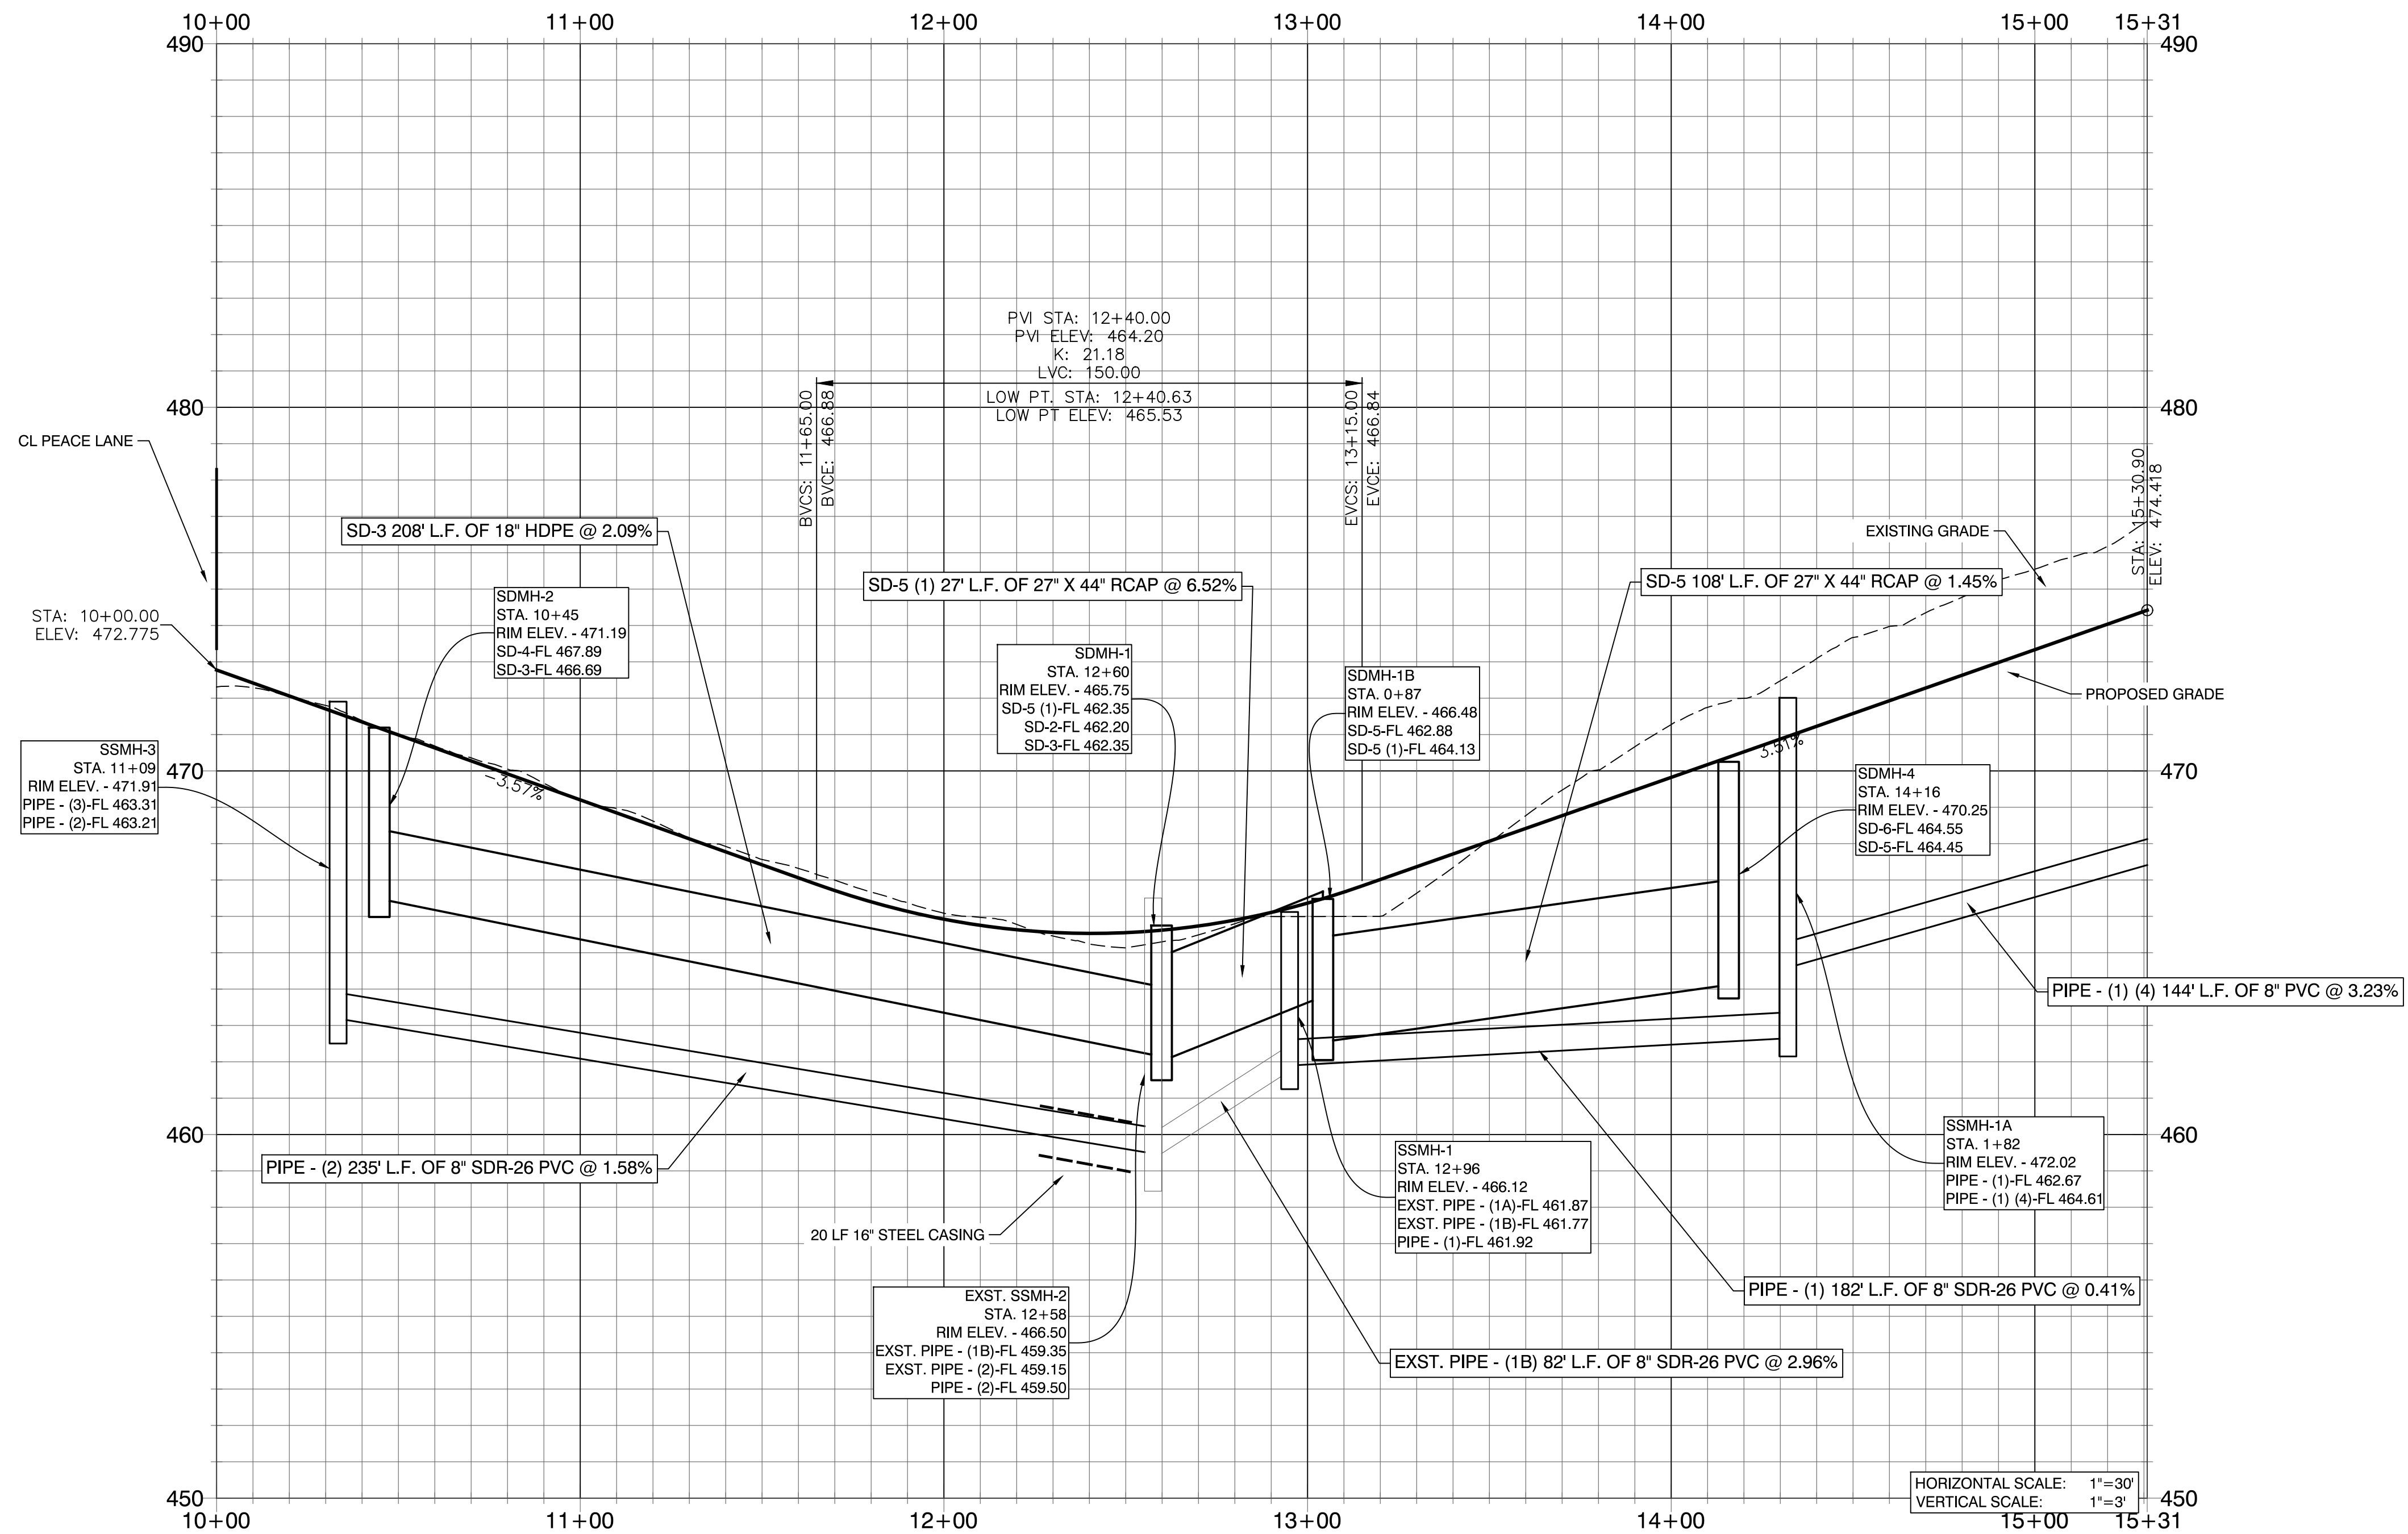

REVISION	DATE	BY
2. REVISED PER CITY OF BRYANT.	2/25/21	GPW

**GNE** Designing our client's success  
**GarNat Engineering, LLC**  
 3825 Mt Carmel Rd  
 Bryant, AR 72022  
 P.O. Box 116  
 Benton, AR 72018  
 PH (501) 408-4650  
 gnatengineering@gmail.com

GRACE VILLAGE SUBDIVISION  
 PHASE 3  
 CITY OF BRYANT,  
 SALINE COUNTY, ARKANSAS

**RECORD  
 DRAWING**

CONTENTS:  
 KINDNESS  
 COURT PROFILE

PROJECT NO:  
 16072


DATE:  
 JAN, 2021

SHEET NO:  
 5


J:\Projects\2021\Projects\16072\Grace Village Phase 3\Drawings\DWG\PHASE 3\KINDNESS-COURT-PROFILE.dwg



SANITARY SEWER SSMH-1 TO SSMH-2 PROFILE

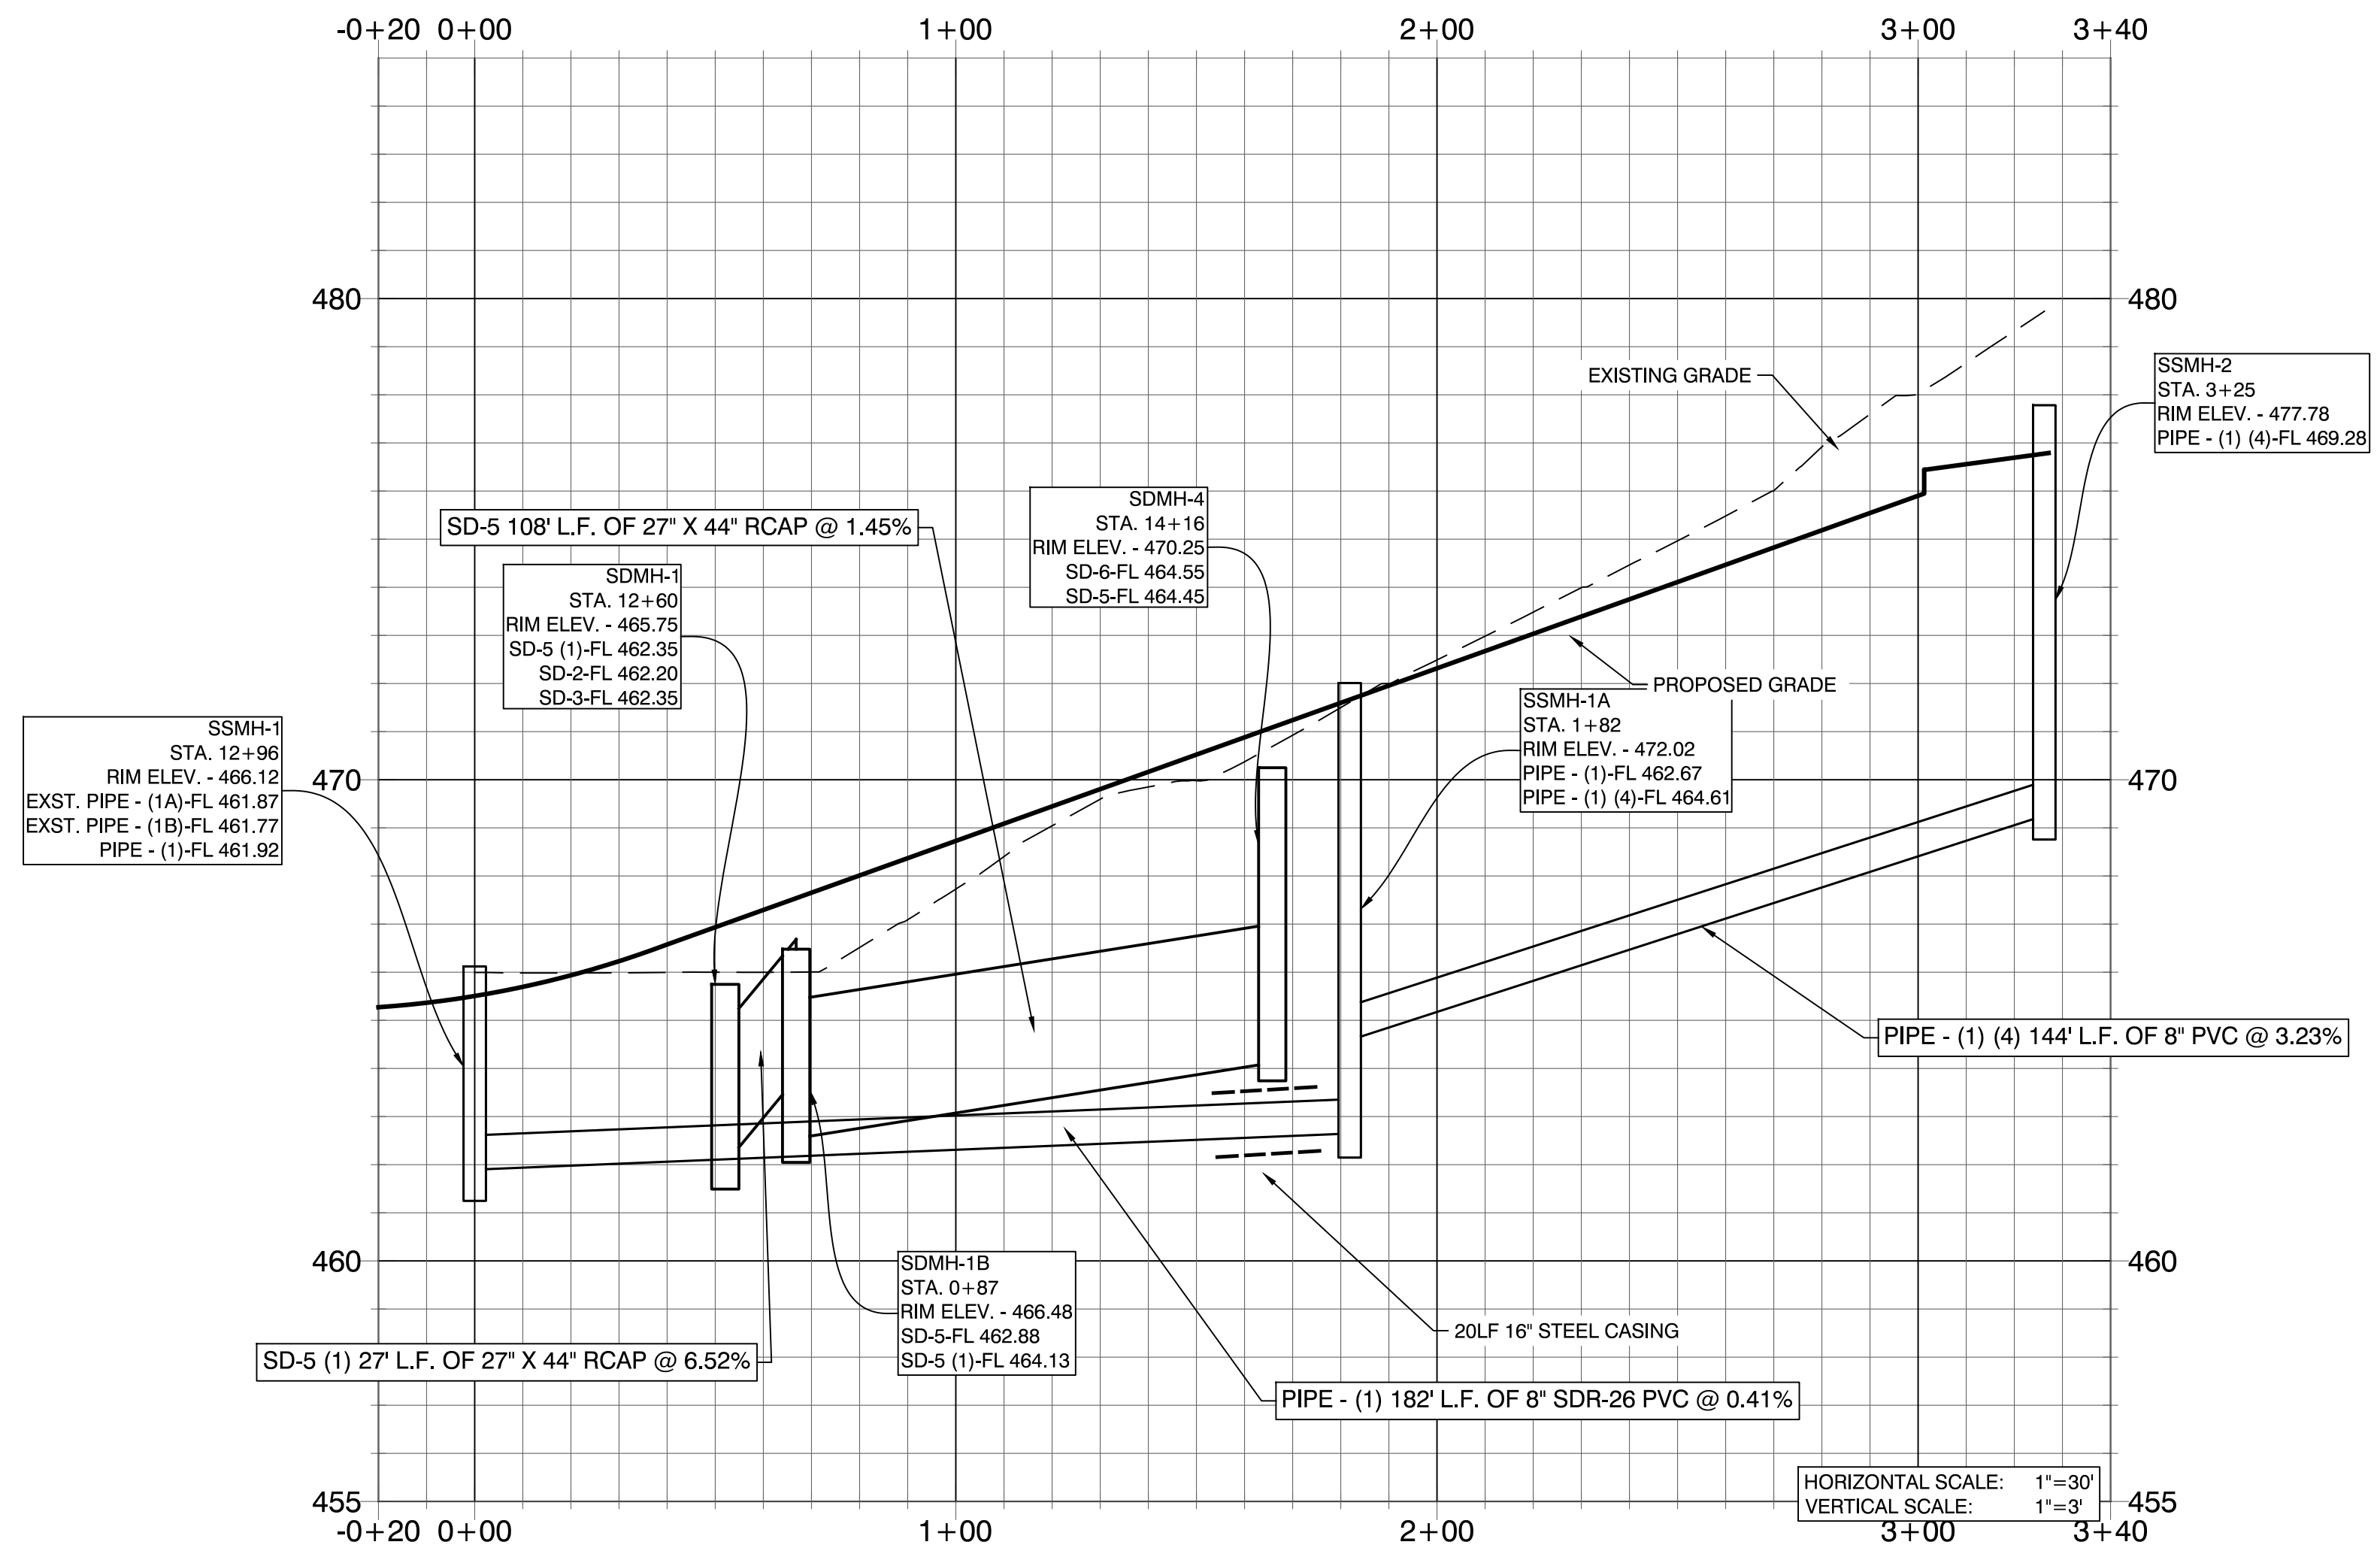

HORIZONTAL SCALE: 1"=30'  
VERTICAL SCALE: 1"=3'

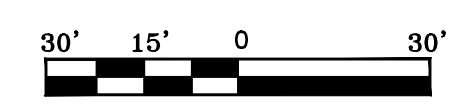

DATE	REVISION	BY
2/25/21	2. REVISED PER CITY OF BRYANT.	GPW

**GNE** Designing our client's success  
**GarNat Engineering, LLC**  
 P.O. Box 116  
 Benton, AR 72018  
 Ph: (501) 408-4650

3825 Mt. Carmel Rd  
 Bryant, AR 72022  
 gnatengineering@gmail.com

GRACE VILLAGE SUBDIVISION  
 PHASE 3  
 CITY OF BRYANT,  
 SALINE COUNTY, ARKANSAS

**RECORD  
 DRAWING**

CONTENTS:  
 SANITARY SEWER PROFILE SSMH-1 TO SSMH-2

PROJECT NO:  
 16072


DATE:  
 JAN, 2021

SHEET NO:  
 6


A:\Projects\2018 Projects\16072 Grace Village Phase 3\Drawings\DWG\PHASE 3 SANITARY SEWER PROFILE SSMH-1 TO SSMH-2.dwg



OUTLET STRUCTURE - JB-1 PROFILE

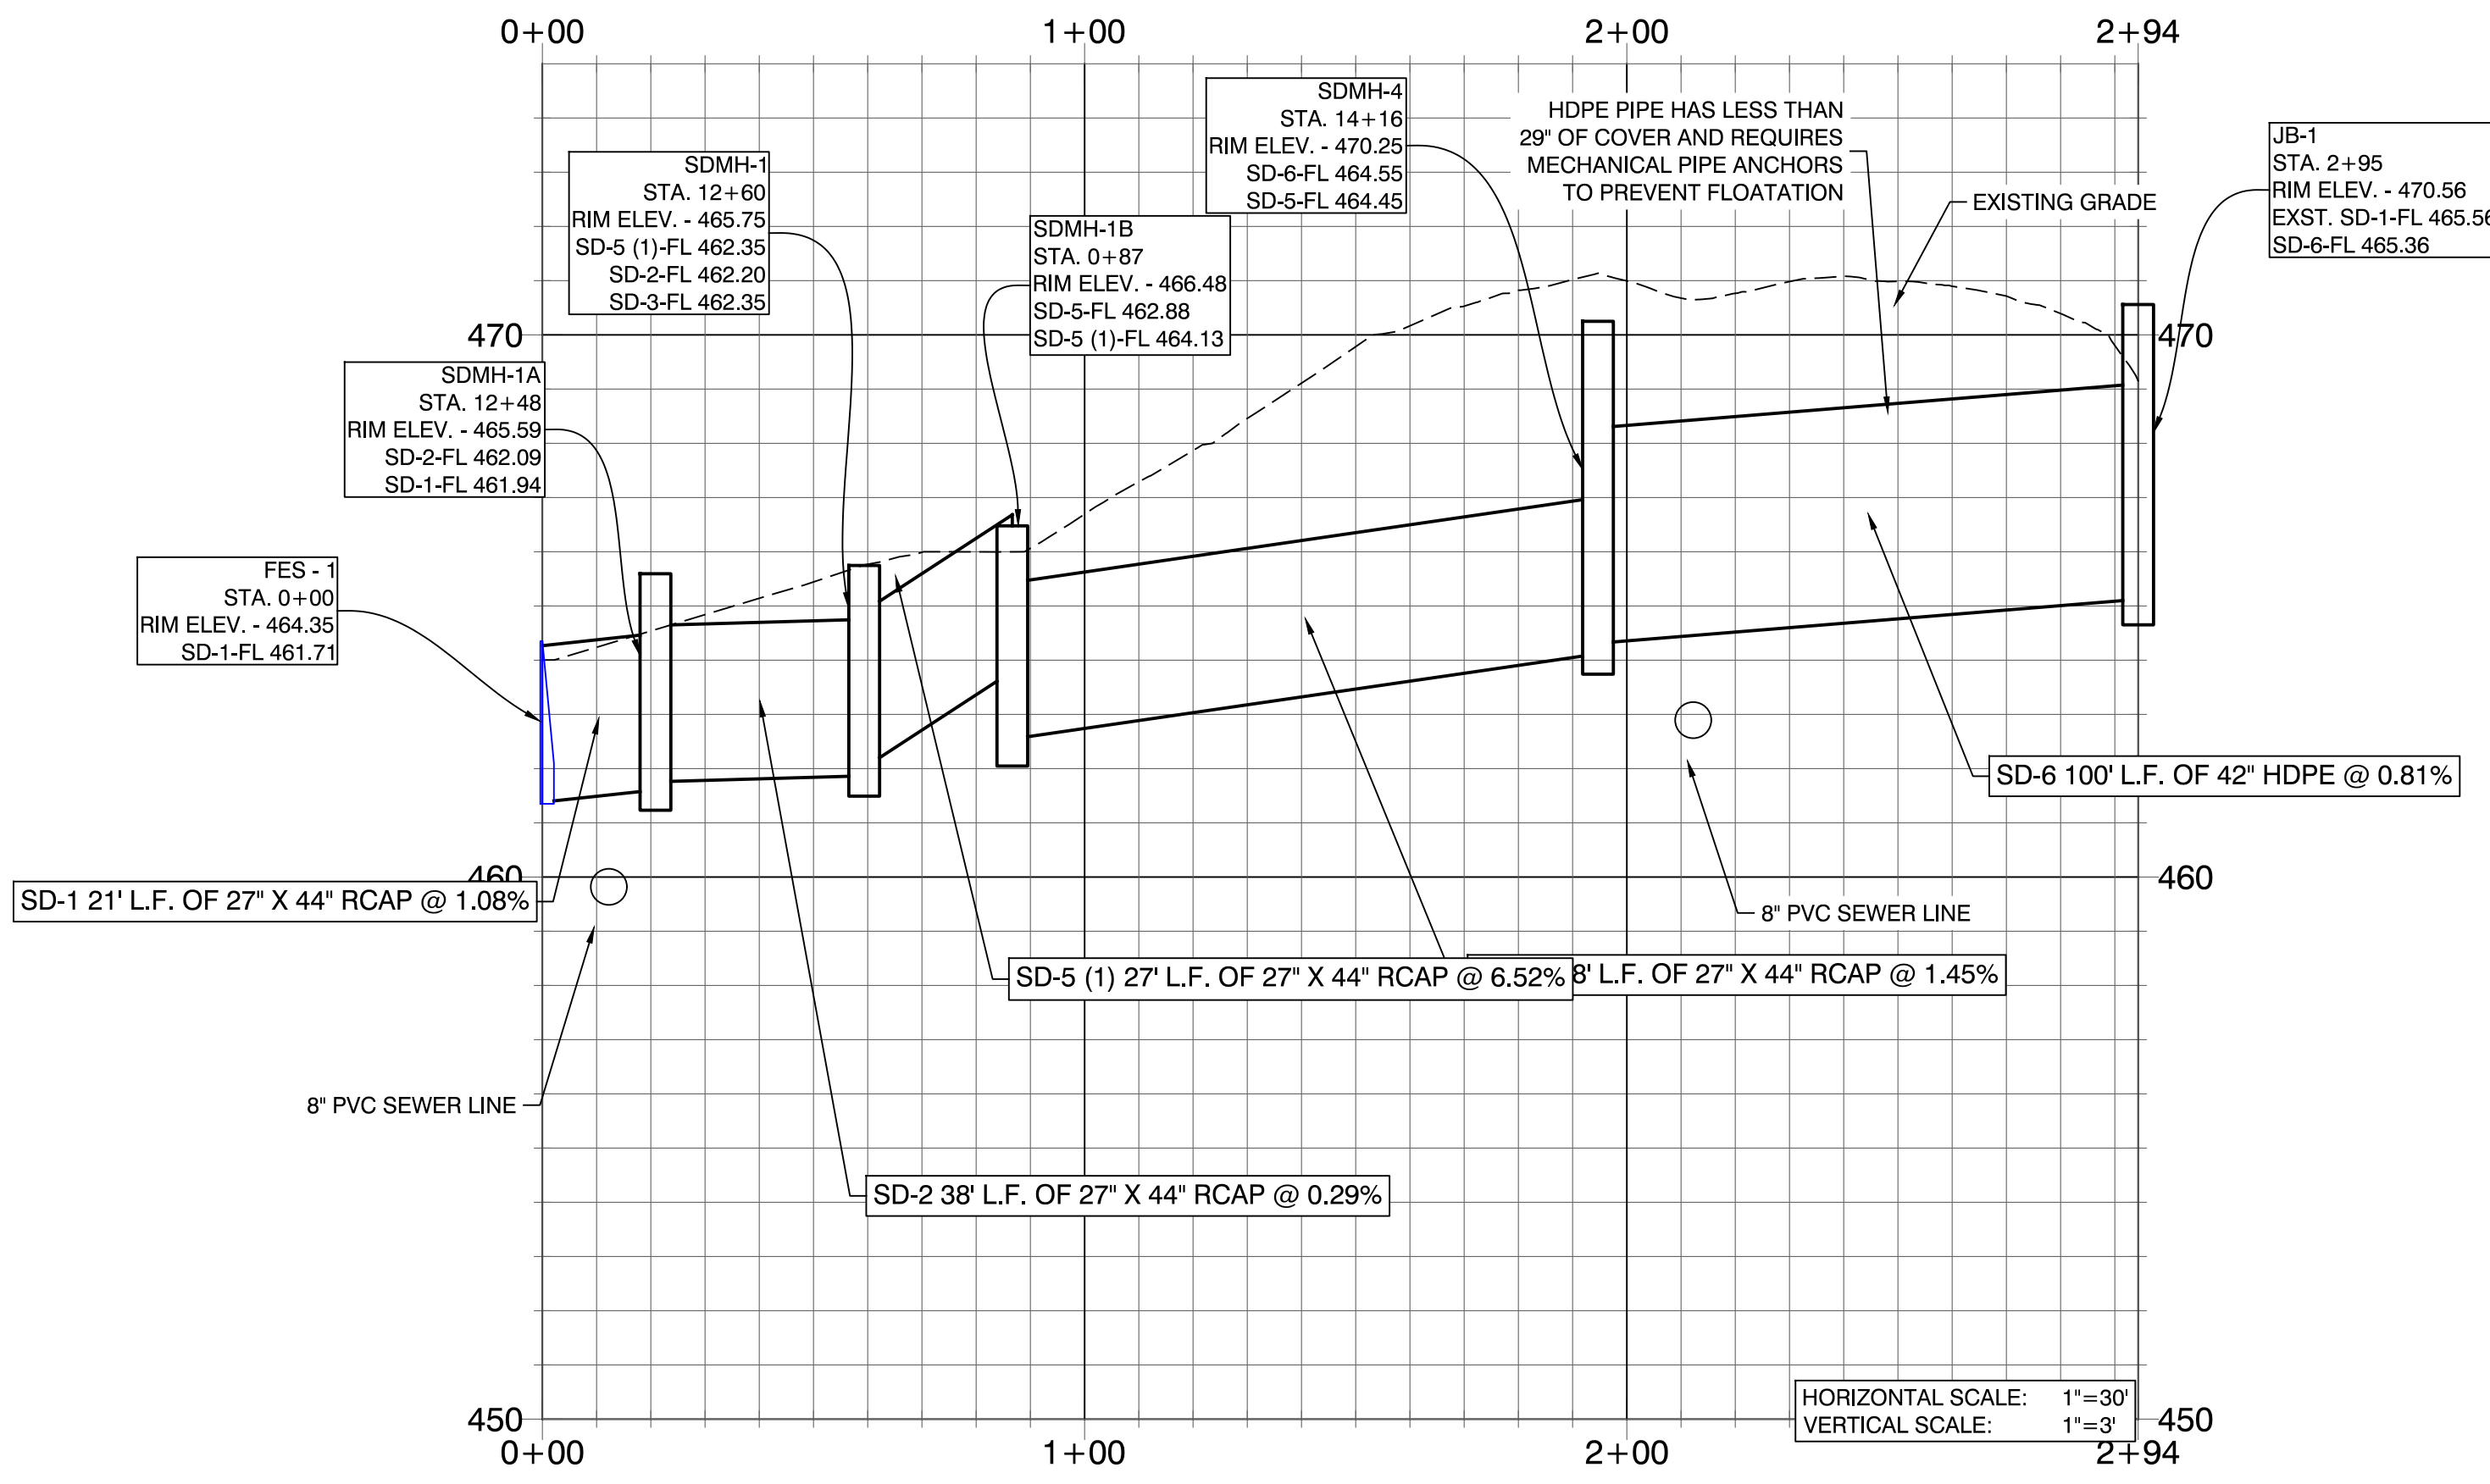

SDMH-1 - SDMH-3 PROFILE

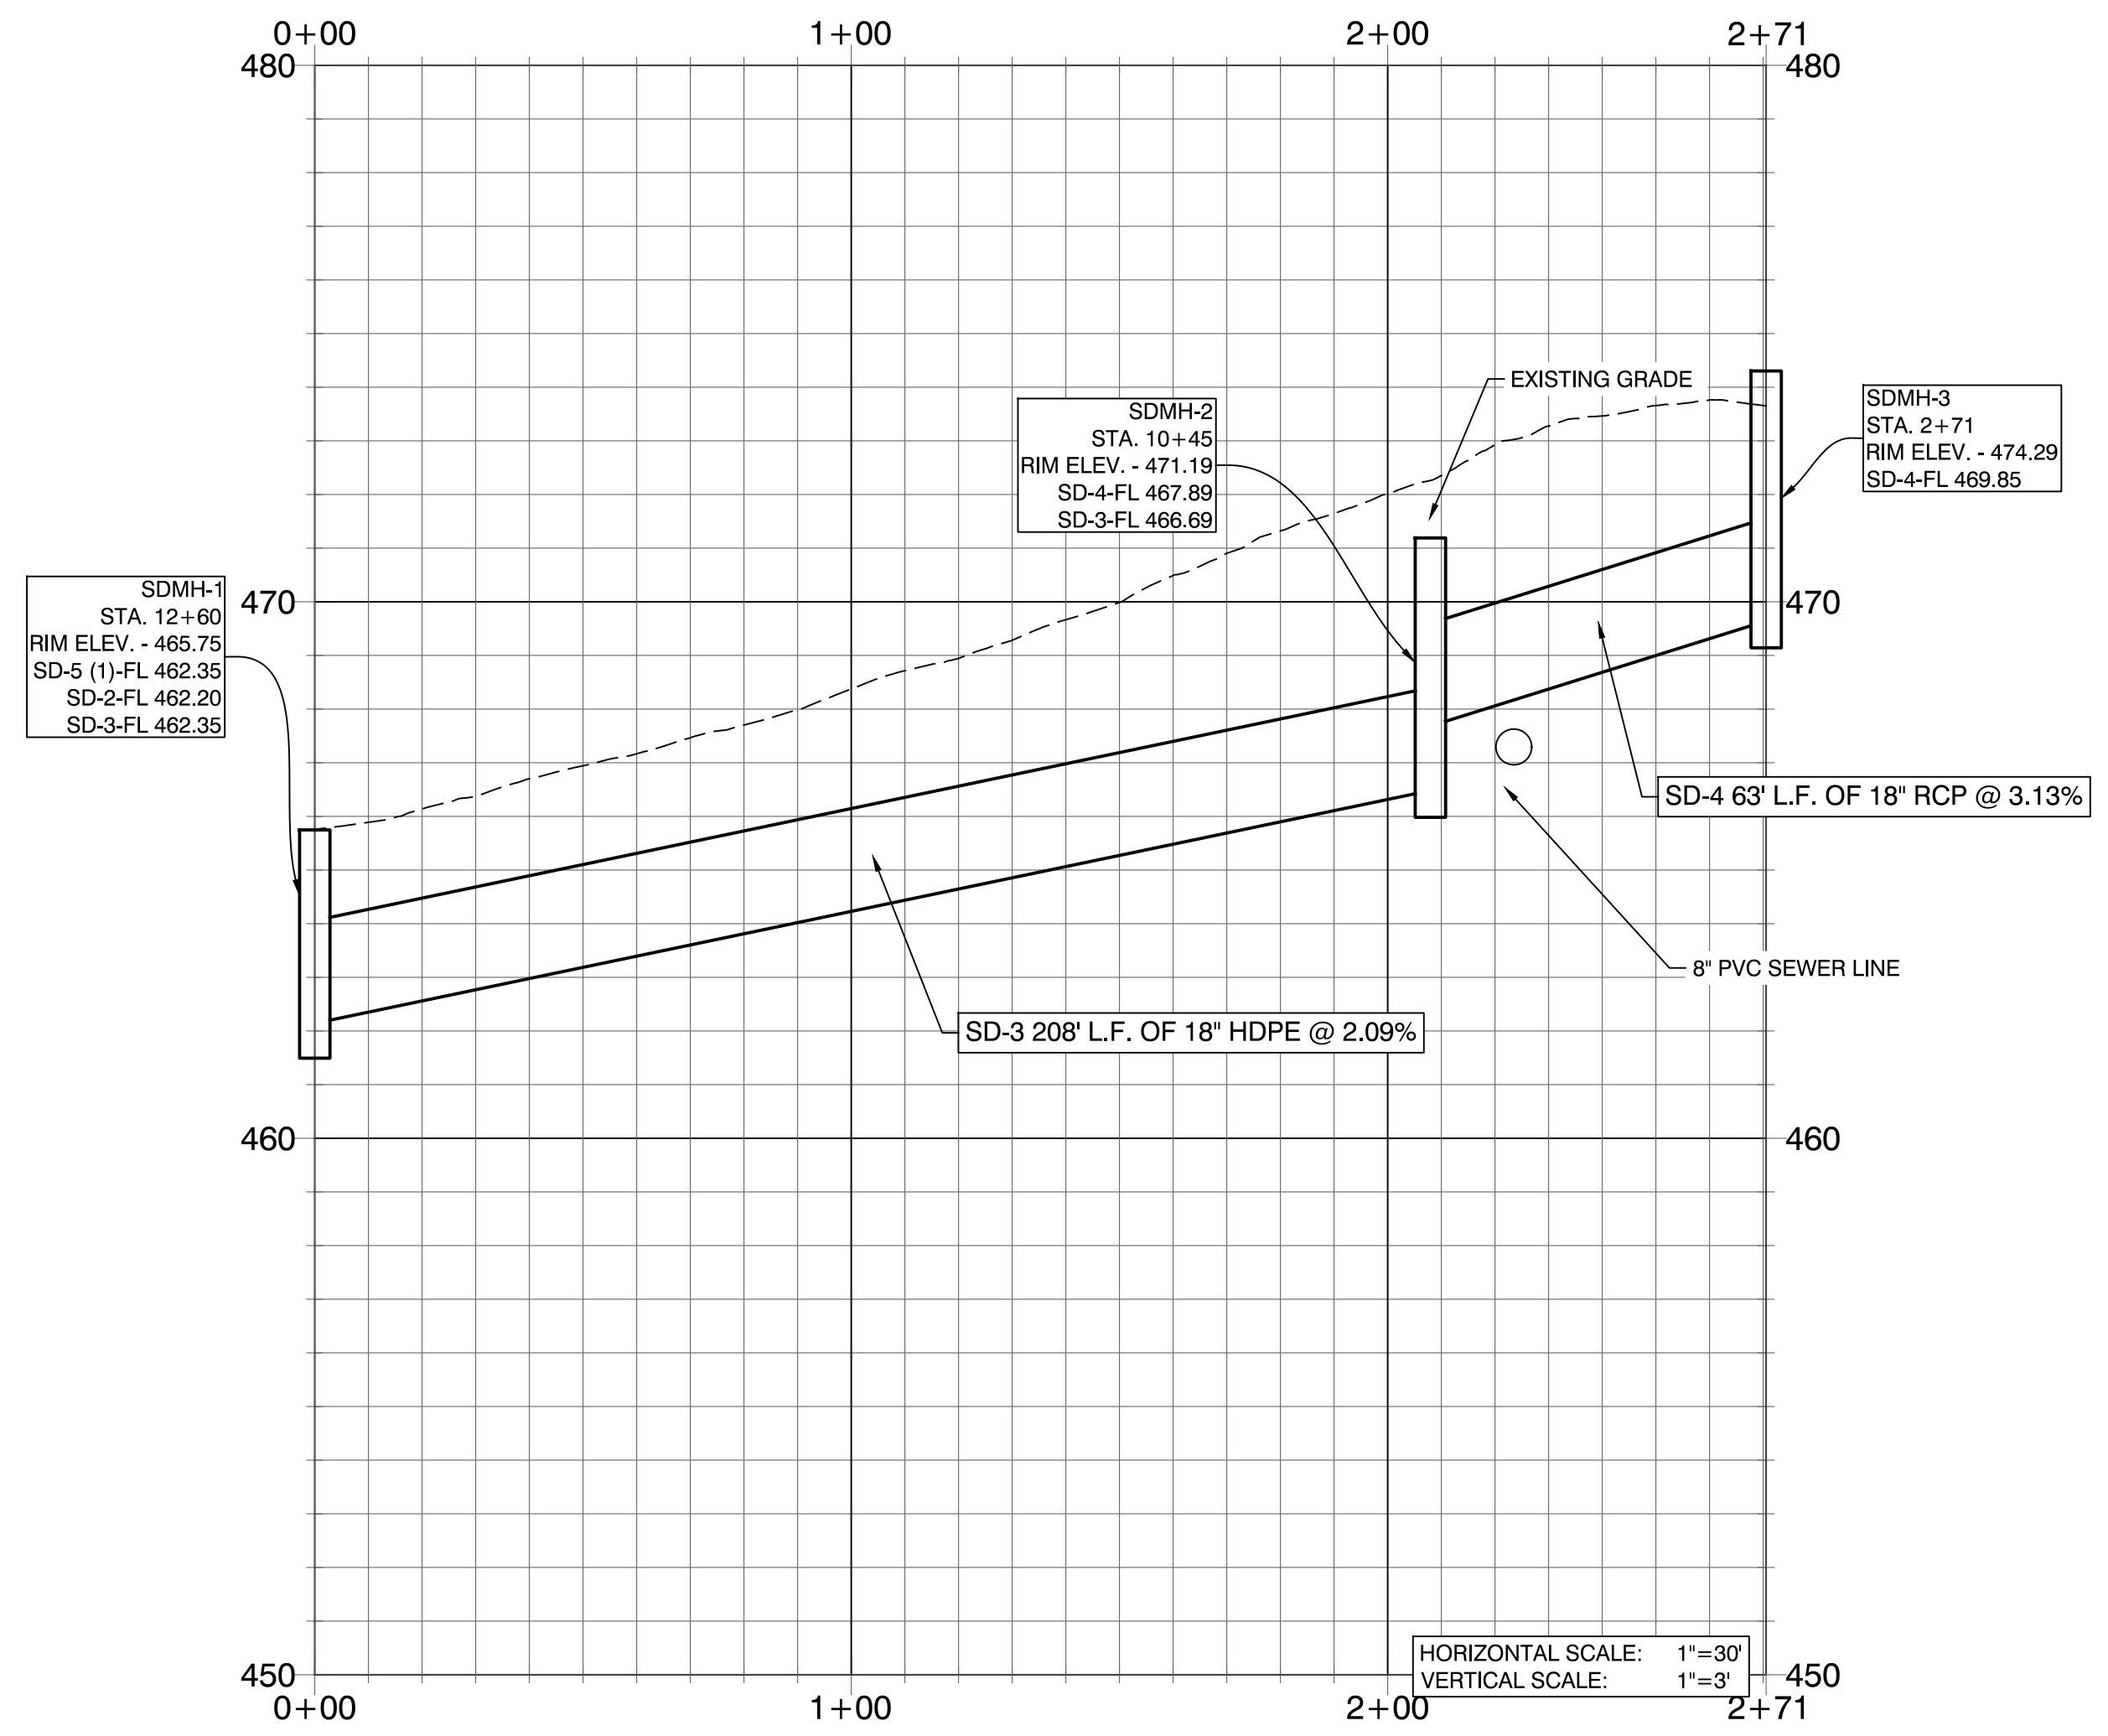

DATE	REVISION	BY
2/11/21	1. REVISED PER CITY OF BRYANT.	ATV
2/25/21	2. REVISED PER CITY OF BRYANT.	GPW

**GNE** Designing our client's success  
**GarNat Engineering, LLC**  
 P.O. Box 116  
 Benton, AR 72018  
 Ph: (501) 408-4650  
 3825 Mt Carmel Rd  
 Bryant, AR 72022  
 gnatengineering@gmail.com

GRACE VILLAGE SUBDIVISION  
 PHASE 3  
 CITY OF BRYANT,  
 SALINE COUNTY, ARKANSAS


**RECORD  
 DRAWING**

CONTENTS:  
 DRAINAGE  
 PROFILES


PROJECT NO:  
 16072  
 DATE:  
 JAN, 2021  
 SHEET NO:

7




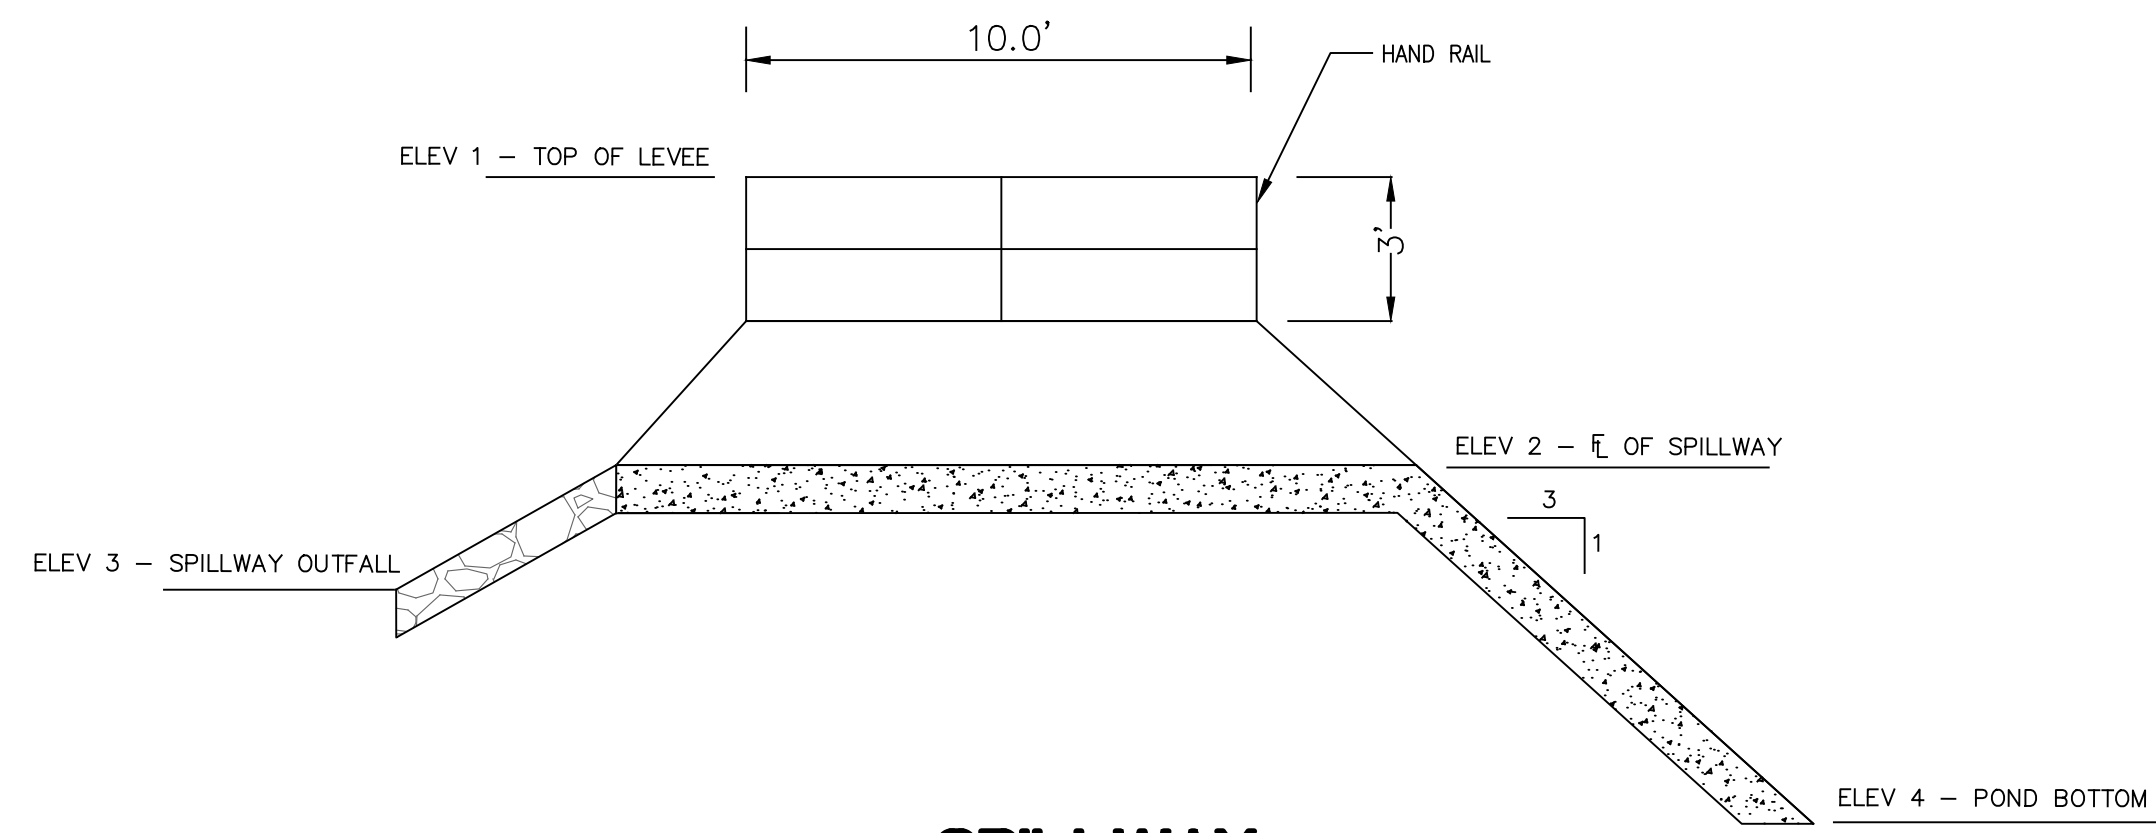

**SPILLWAY SECTION A-A**  
NOT TO SCALE

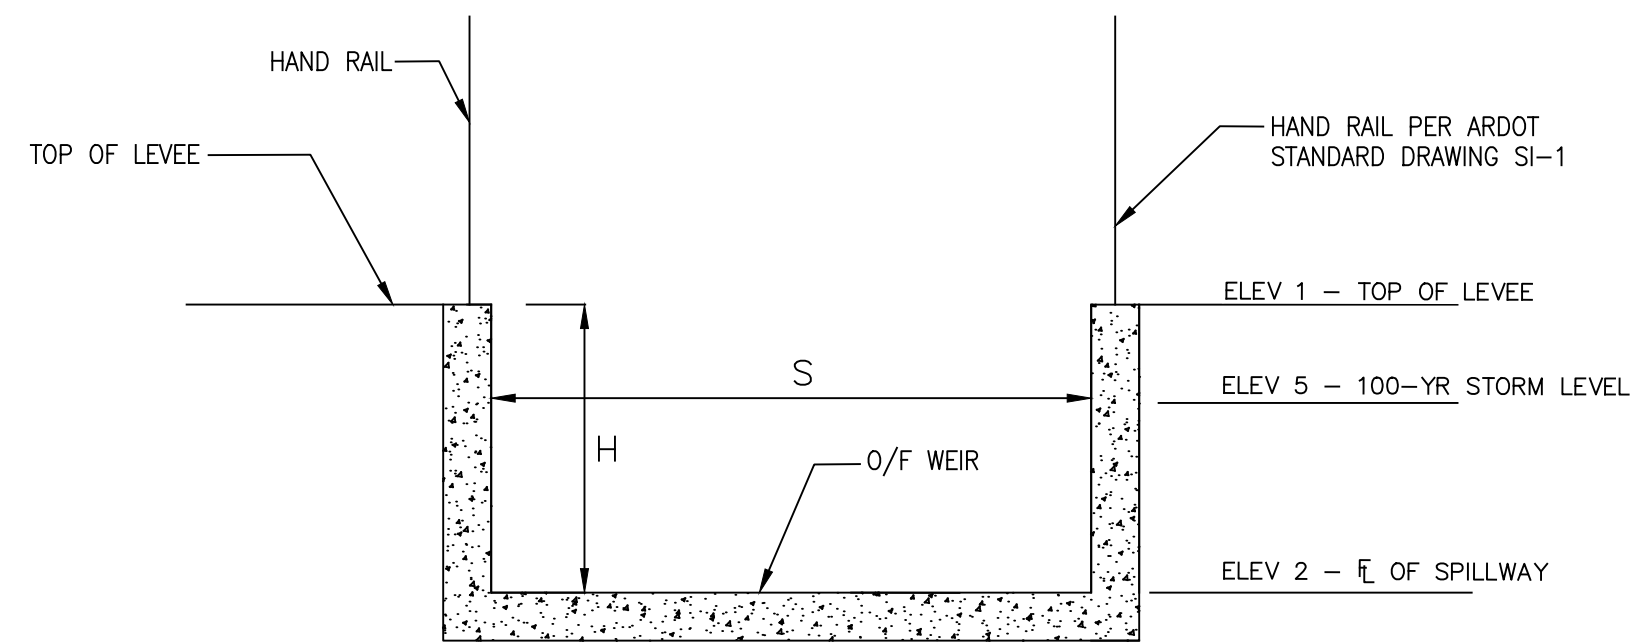

**SPILLWAY SECTION B-B**  
NOT TO SCALE

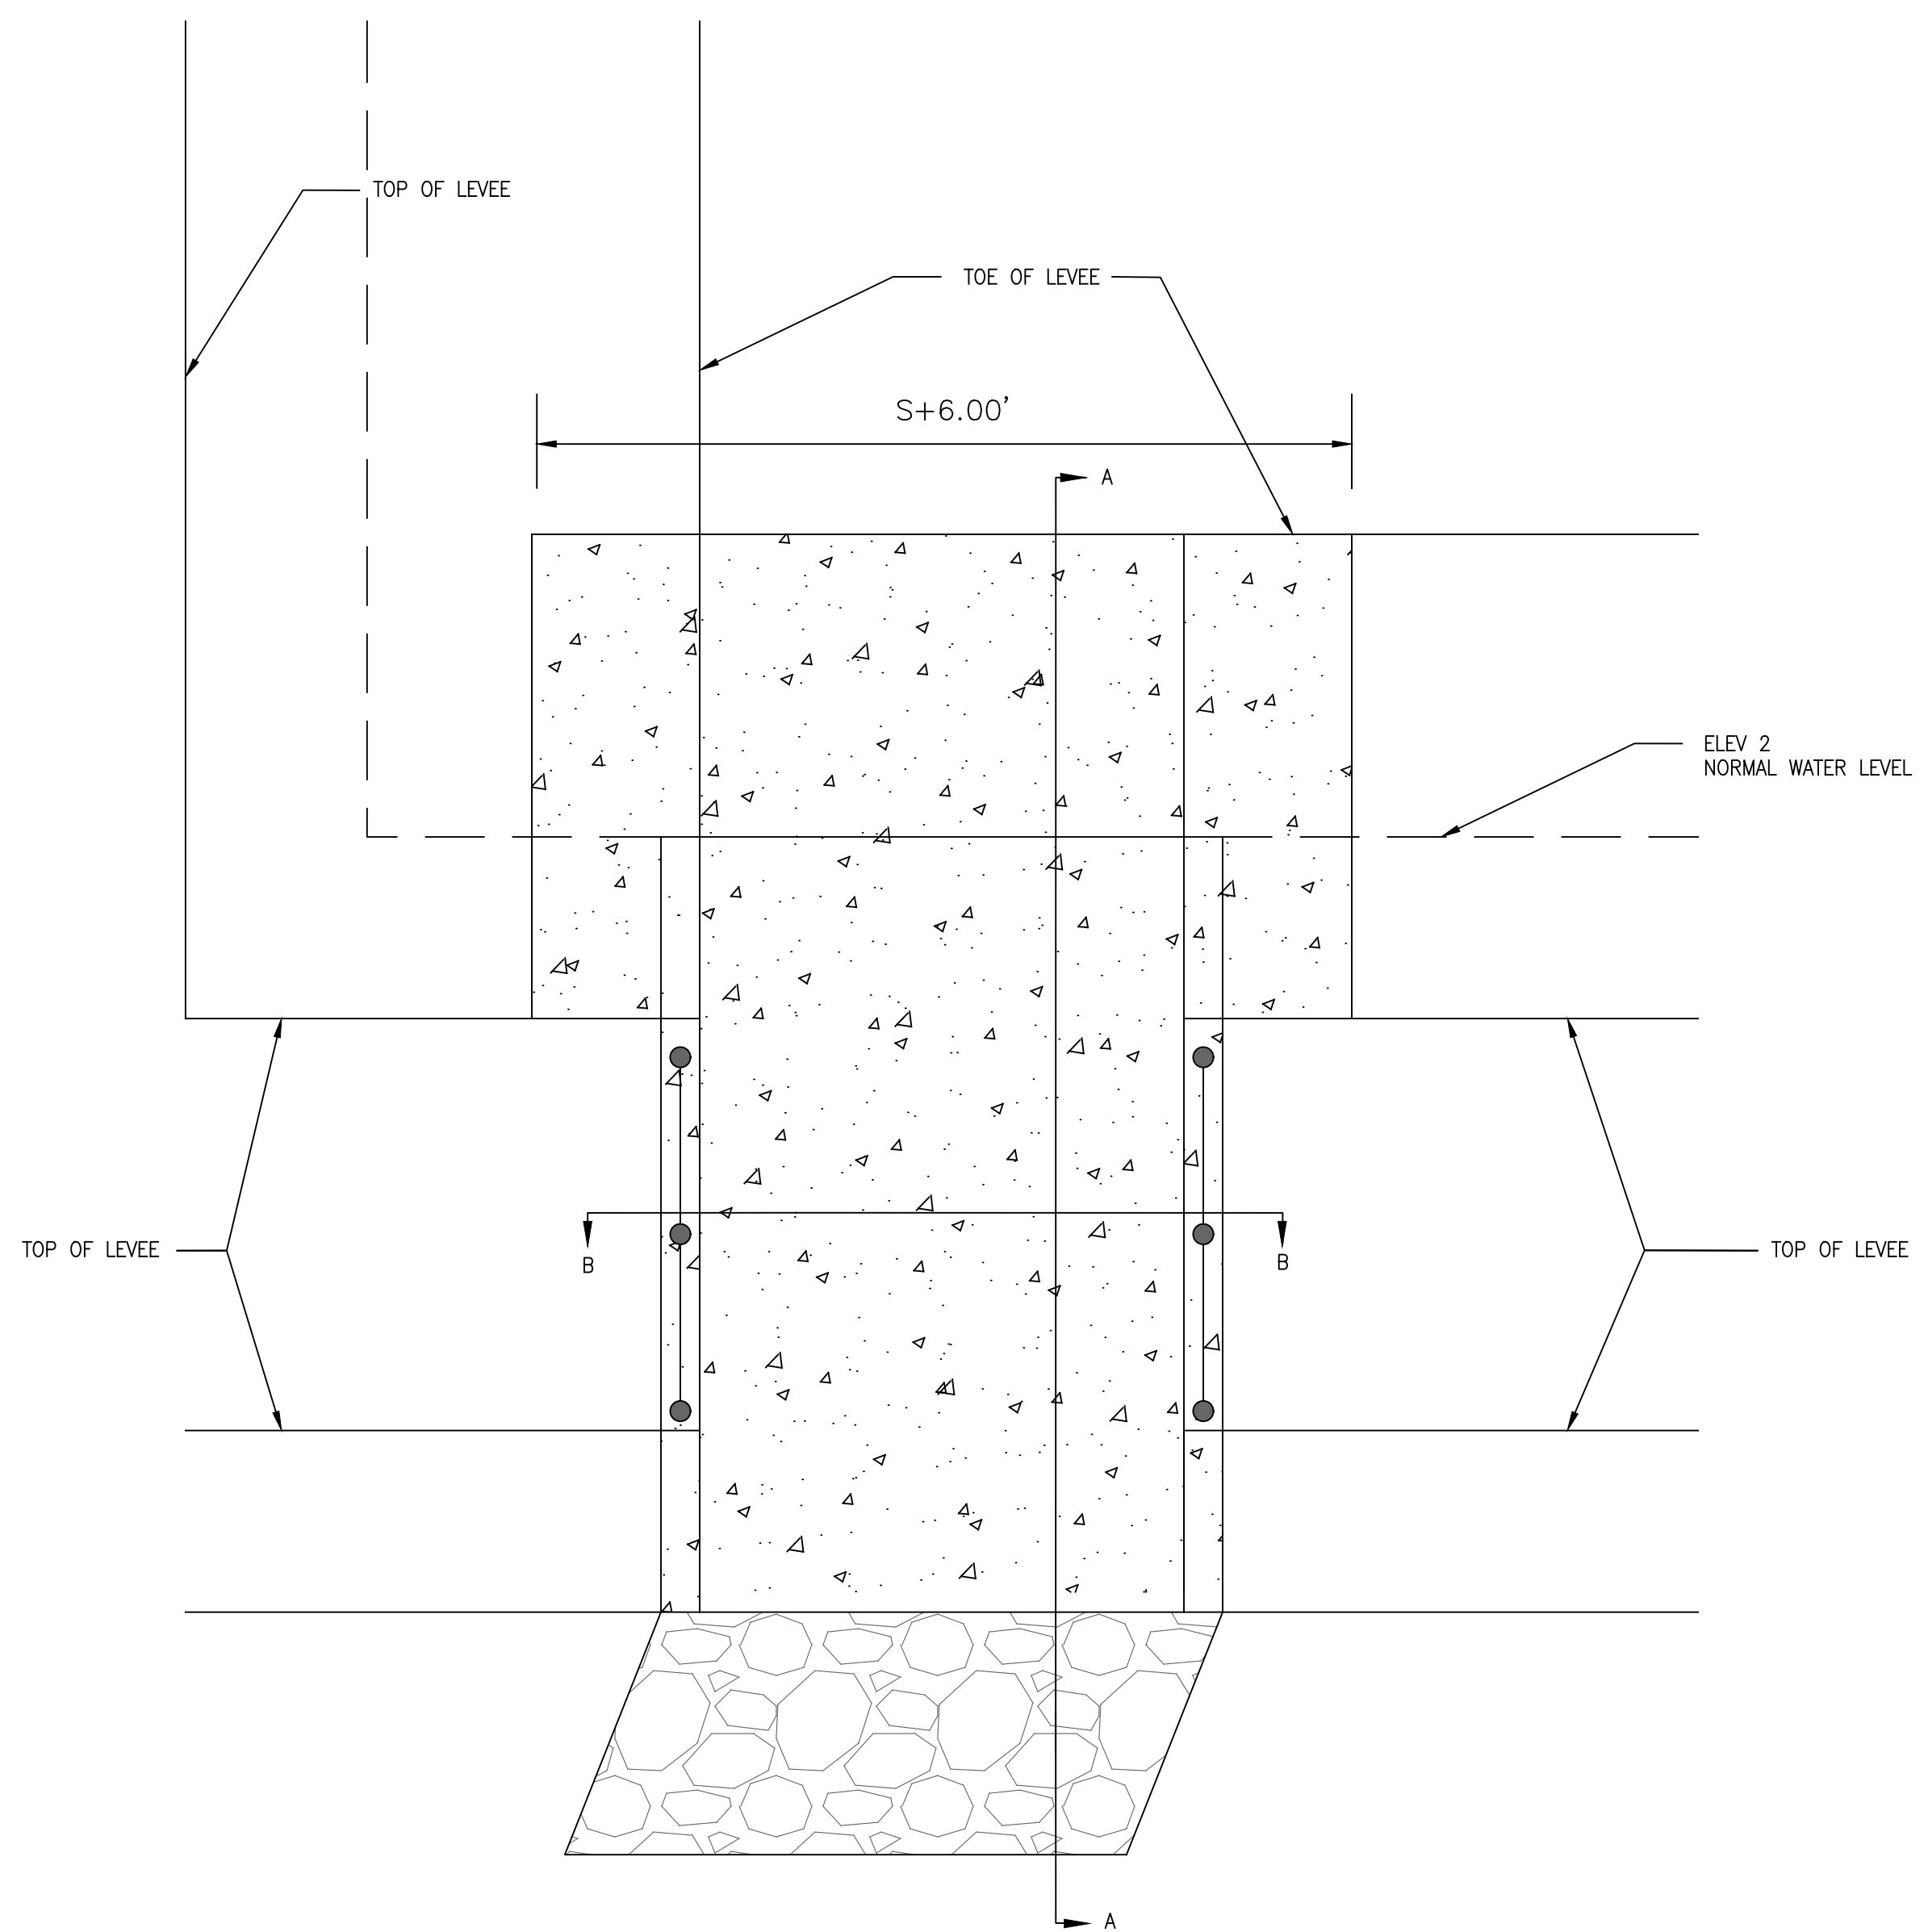

**SPILLWAY PLAN VIEW**  
NOT TO SCALE

CONTROL STRUCTURE							
SPILLWAY	H	ELEV 1	ELEV 2	ELEV 3	ELEV 4	ELEV 5	S
1	3'-0"	464.00	461.00	460.95	456.00	463.00	11'-3"

- DETENTION OUTLET NOTES:**
- ALL CONCRETE WALLS SHALL BE A MINIMUM OF 6" THICK & REINFORCED WITH #4'S @ 12" O.C. BOTHWAYS.

BY	
REVISION	
DATE	
<p><b>GNE</b> Designing our client's success  <b>GarNat Engineering, LLC</b>          3825 Mt. Camel Rd          Bryant, AR 72022          garnatengineering@gmail.com</p> <p>P.O. Box 116          Benton, AR 72018          Ph (501) 408-4650</p>	
<p>GRACE VILLAGE SUBDIVISION          PHASE 3          CITY OF BRYANT,          SALINE COUNTY, ARKANSAS</p>	
<p><b>RECORD DRAWING</b></p>	
<p>CONTENTS:          SPILLWAY DETAILS</p>	
PROJECT NO:	16072
DATE:	JAN, 2021
SHEET NO:	8