




**HOPE CONSULTING**  
ENGINEERS - SURVEYORS

117 S. Market Street,  
Benton, Arkansas 72015  
PH. (501)315-2626  
FAX (501) 315-0024  
www.hopeconsulting.com

FOR USE AND BENEFIT OF:		
<b>OLTMANS DEVELOPMENT</b>		
<b>CORAL RIDGE SUBDIVISION</b>		
<b>DRAINAGE AS-BUILT'S PLAN</b>		
<b>BRYANT, SALINE COUNTY, ARKANSAS</b>		
DATE: 09/26/2022	C.A.D. BY:	DRAWING NUMBER:
REVISED:	CHECKED BY:	<b>21-0209</b>
SHEET:	SCALE:	




VICINITY MAP:

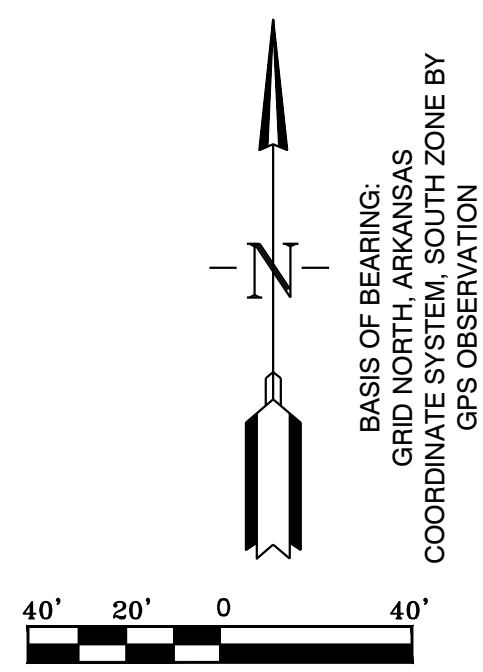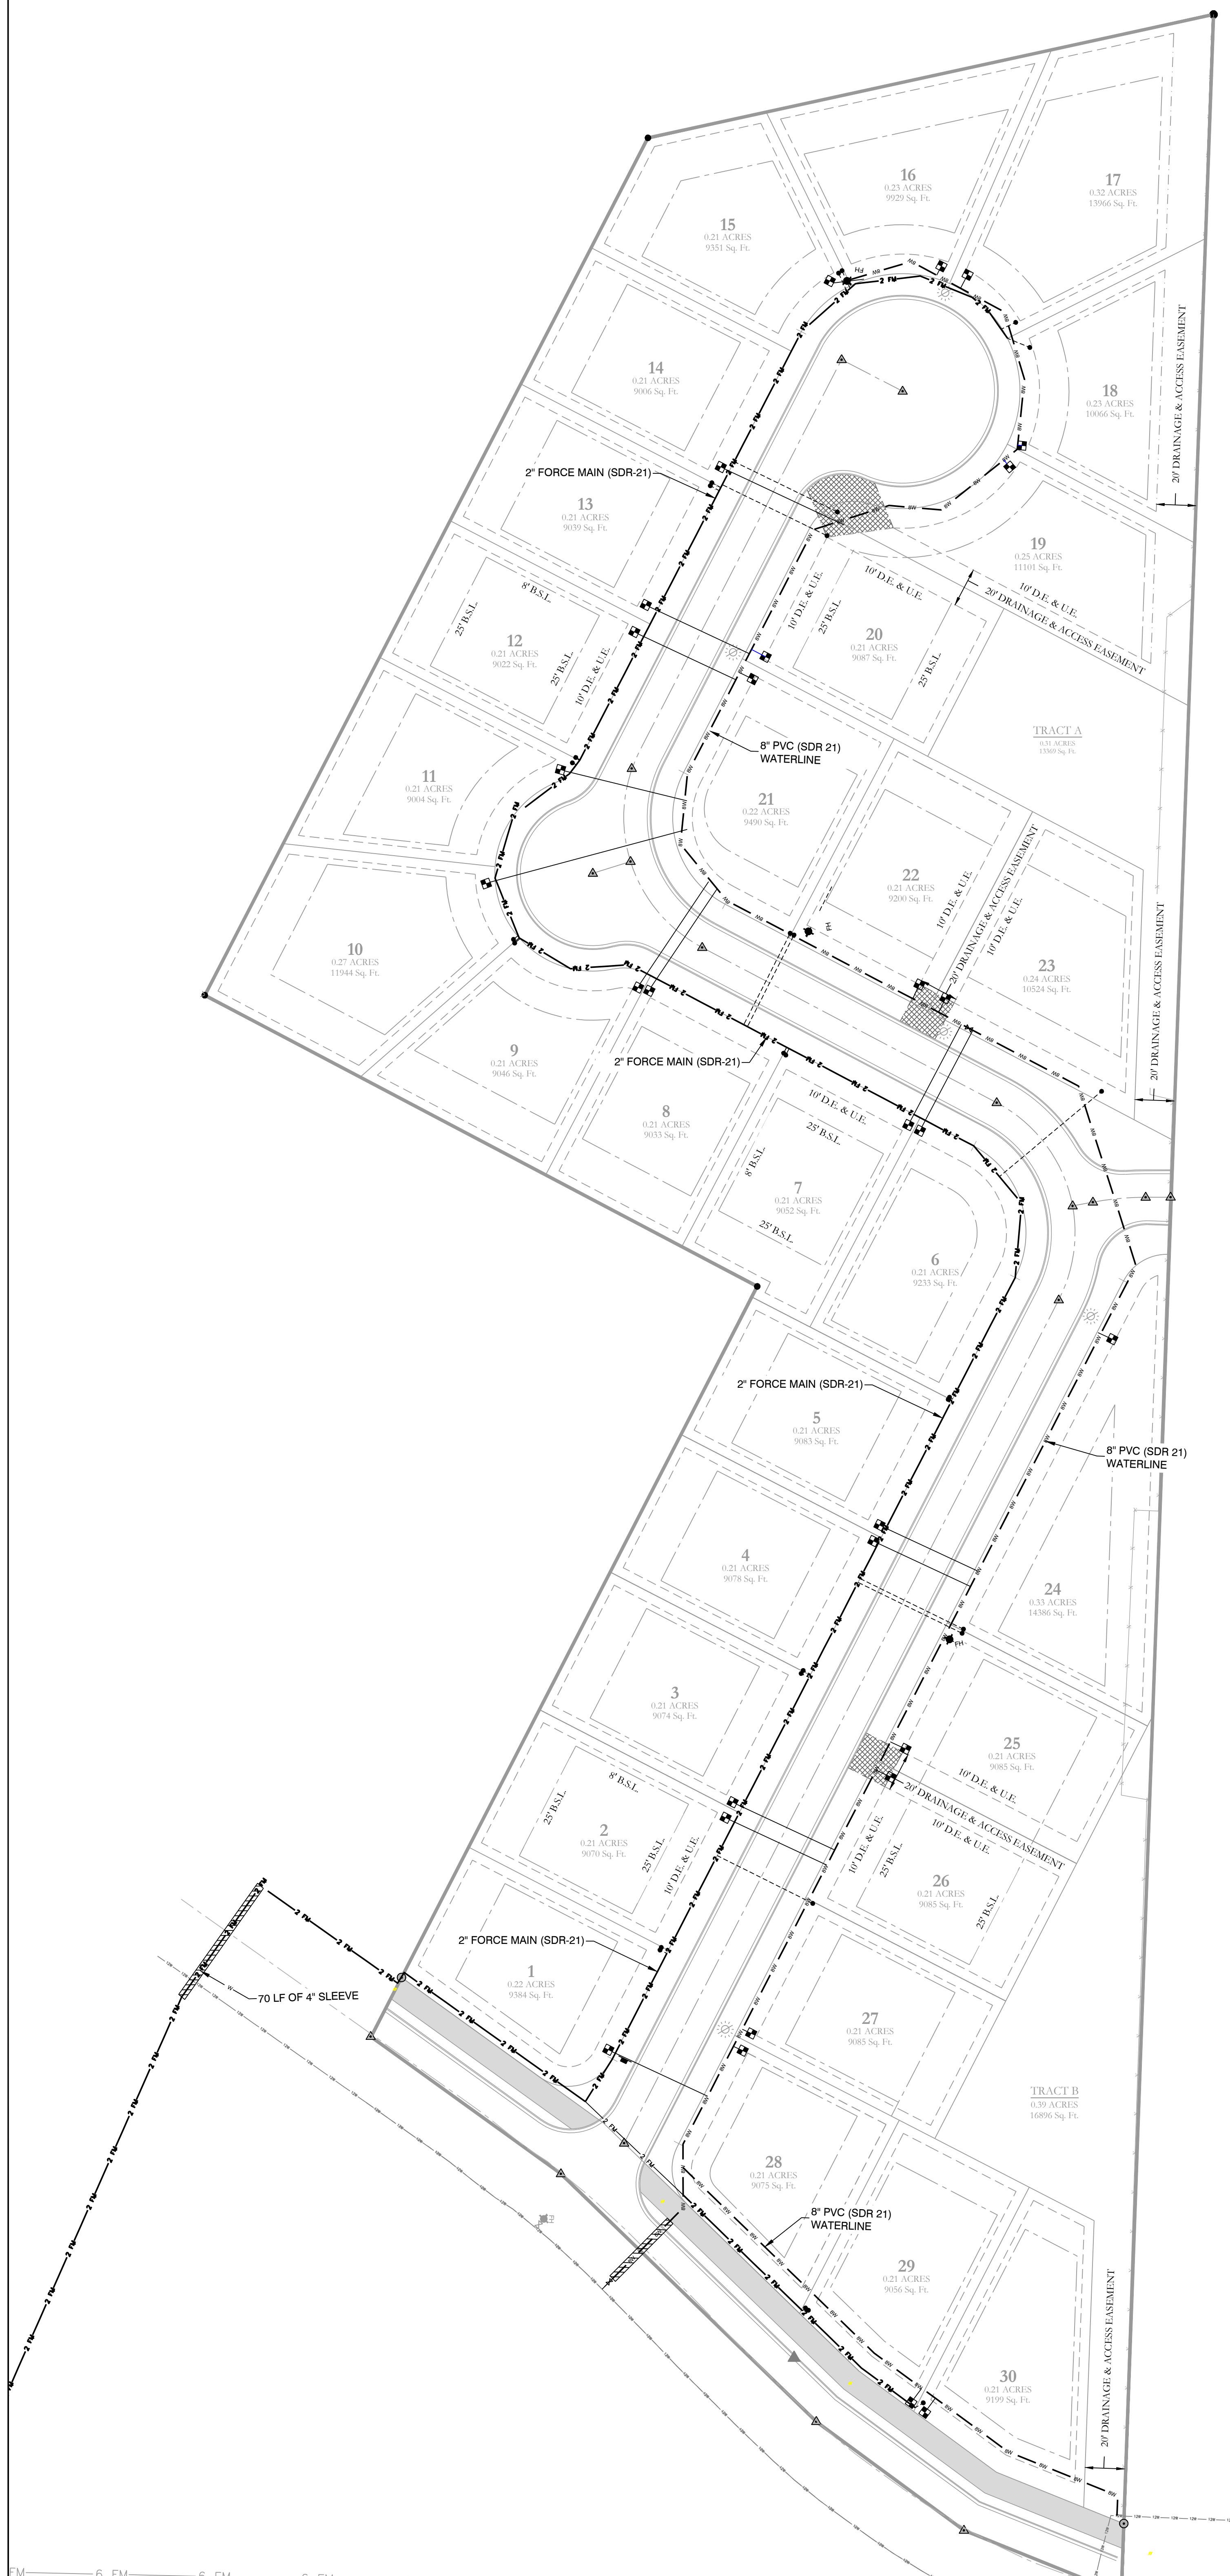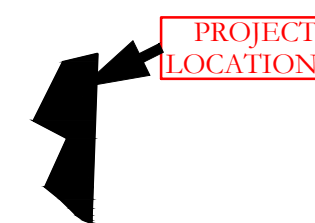

BASIS OF BEARING:  
GRID NORTH, ARKANSAS  
COORDINATE SYSTEM, SOUTH ZONE BY  
GPS OBSERVATION

WATER LEGEND:

	DUAL WATER METERS
	SINGLE WATER METER
	GATE VALVE
	45° FITTING
	90° FITTING
	TEE FITTING
	CROSS FITTING
	FIRE HYDRANT

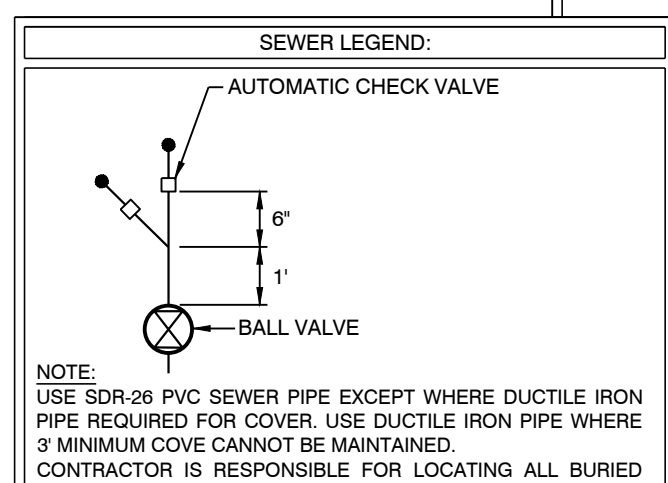

**HOPE CONSULTING ENGINEERS - SURVEYORS**  
 117 S. Market Street,  
 Benton, Arkansas 72015  
 PH. (501)315-2626  
 FAX (501) 315-0024  
 www.hopeconsulting.com

FOR USE AND BENEFIT OF:  
**OLTMANS DEVELOPMENT**  
**CORAL RIDGE SUBDIVISION**  
 SANITARY SEWER AND WATER AS-BUILTS PLAN  
 BRYANT, SALINE COUNTY, ARKANSAS

DATE: 09/26/2022	C.A.D. BY:	DRAWING NUMBER:
REVISED: 6/07/2022	CHECKED BY:	21-0209
SHEET: C-3.0	SCALE:	
500	1S	14W 0 3 330 62 1762