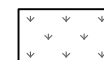

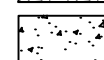
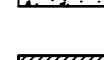
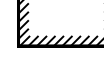


**LEGEND:**

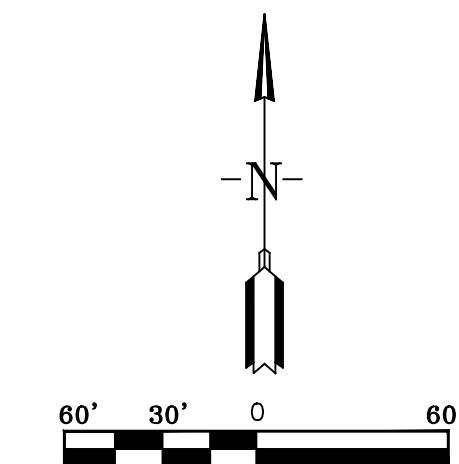
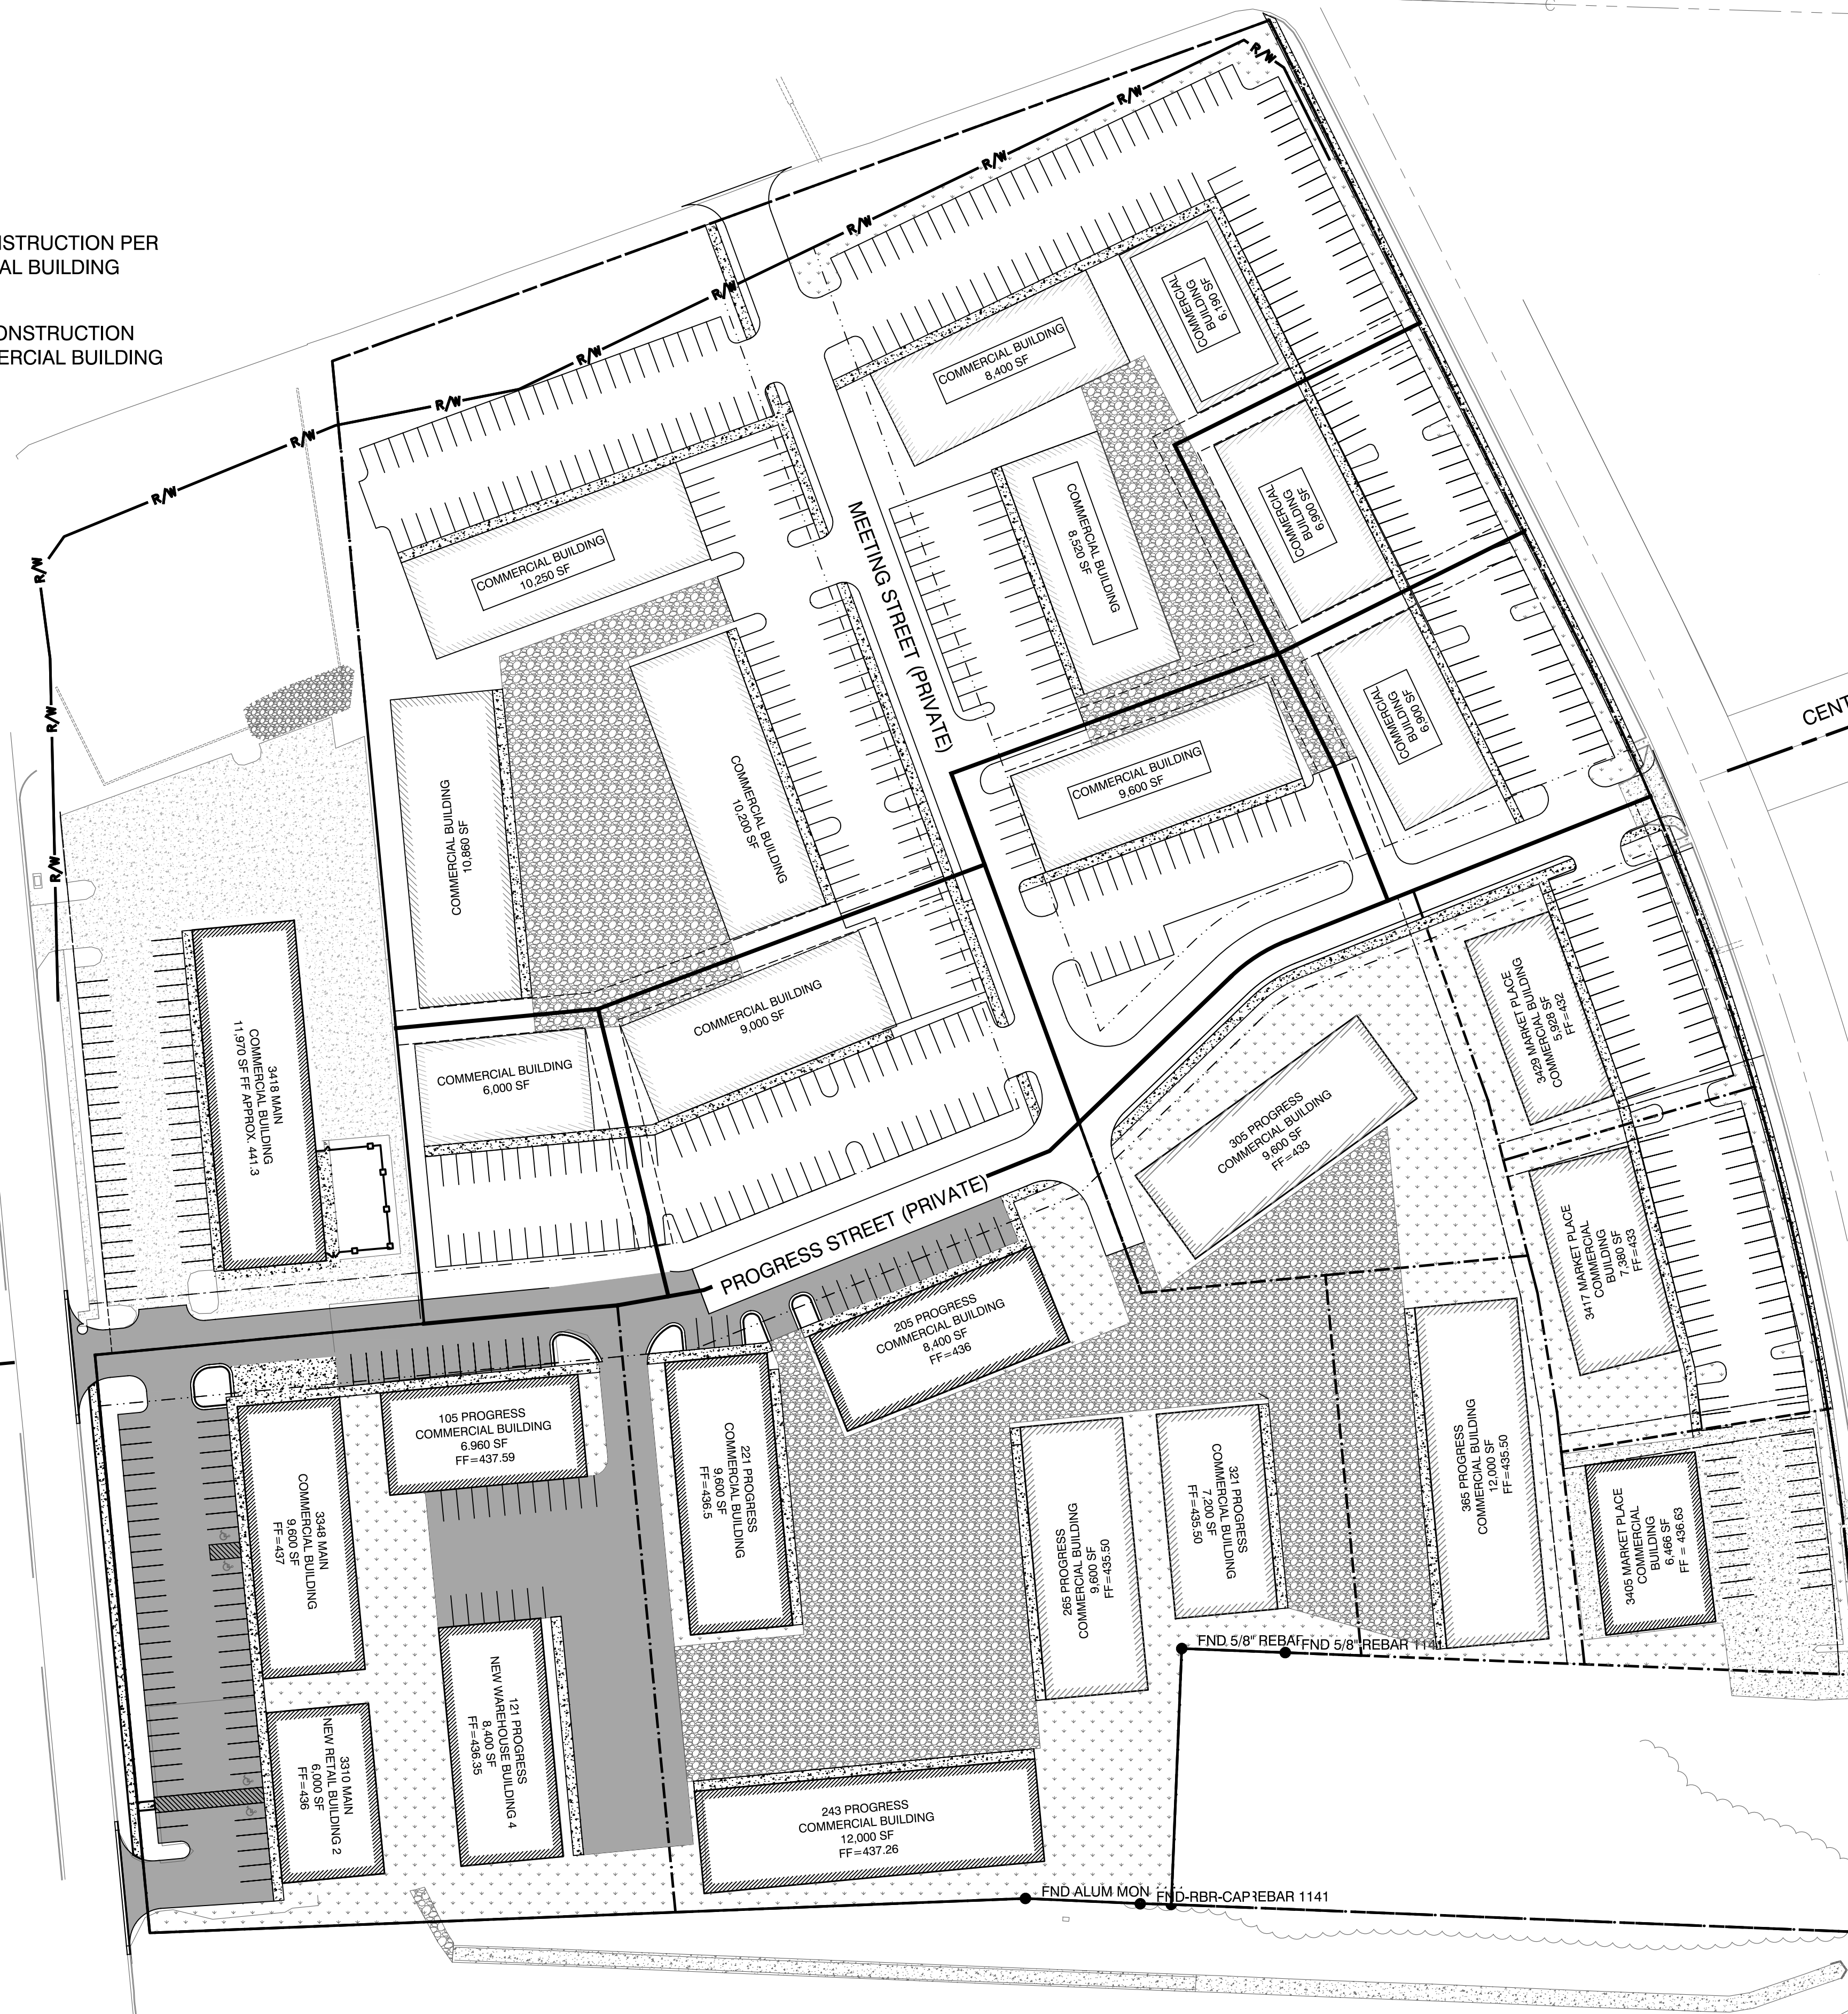
-  GREEN SPACE
-  GRAVEL
-  ASPHALT
-  EXISTING COMMERCIAL CONSTRUCTION PER CITY OF BRYANT COMMERCIAL BUILDING REQUIREMENTS.
-  PROPOSED COMMERCIAL CONSTRUCTION PER CITY OF BRYANT COMMERCIAL BUILDING REQUIREMENTS.

CENTERLINE EXISTING COMMERCIAL DRIVEWAY

CENTERLINE EXISTING COMMERCIAL DRIVEWAY

CENTERLINE EXISTING ROAD

CENTERLINE EXISTING COMMERCIAL DRIVEWAY



BY	REVISION	DATE	REVISION	DATE	REVISION	DATE	REVISION
GPW	REVISED PER AS-BUILT	01-25-22					
<p><b>Designing our client's success</b></p> <p><b>GNE</b> <b>GarNat Engineering, LLC</b></p> <p>P.O. Box 116 Benton, AR 72018 Ph: (501) 408-4650</p> <p>3825 Mt. Carmel Rd Bryant, AR 72022 garnatengineering@gmail.com</p>							
<p><b>MARKET PLACE CENTER</b> <b>CITY OF BRYANT</b> <b>SALINE COUNTY, ARKANSAS</b></p>							
<p><b>PRELIMINARY</b></p>							
CONTENTS:							
<p><b>SCHEMATIC PLAN</b></p>							
PROJECT NO:							
<p><b>18087</b></p>							
DATE:							
<p><b>SEPTEMBER 2022</b></p>							
SHEET NO:							
<p><b>N/A</b></p>							

J:\Projects\2018 Projects\18087\_Bart\_Engstrom - Market Place Center\Drawings\DWG\18087 - Schematic - 01-25-22-18.dwg