




Know what's below.
Call before you dig.

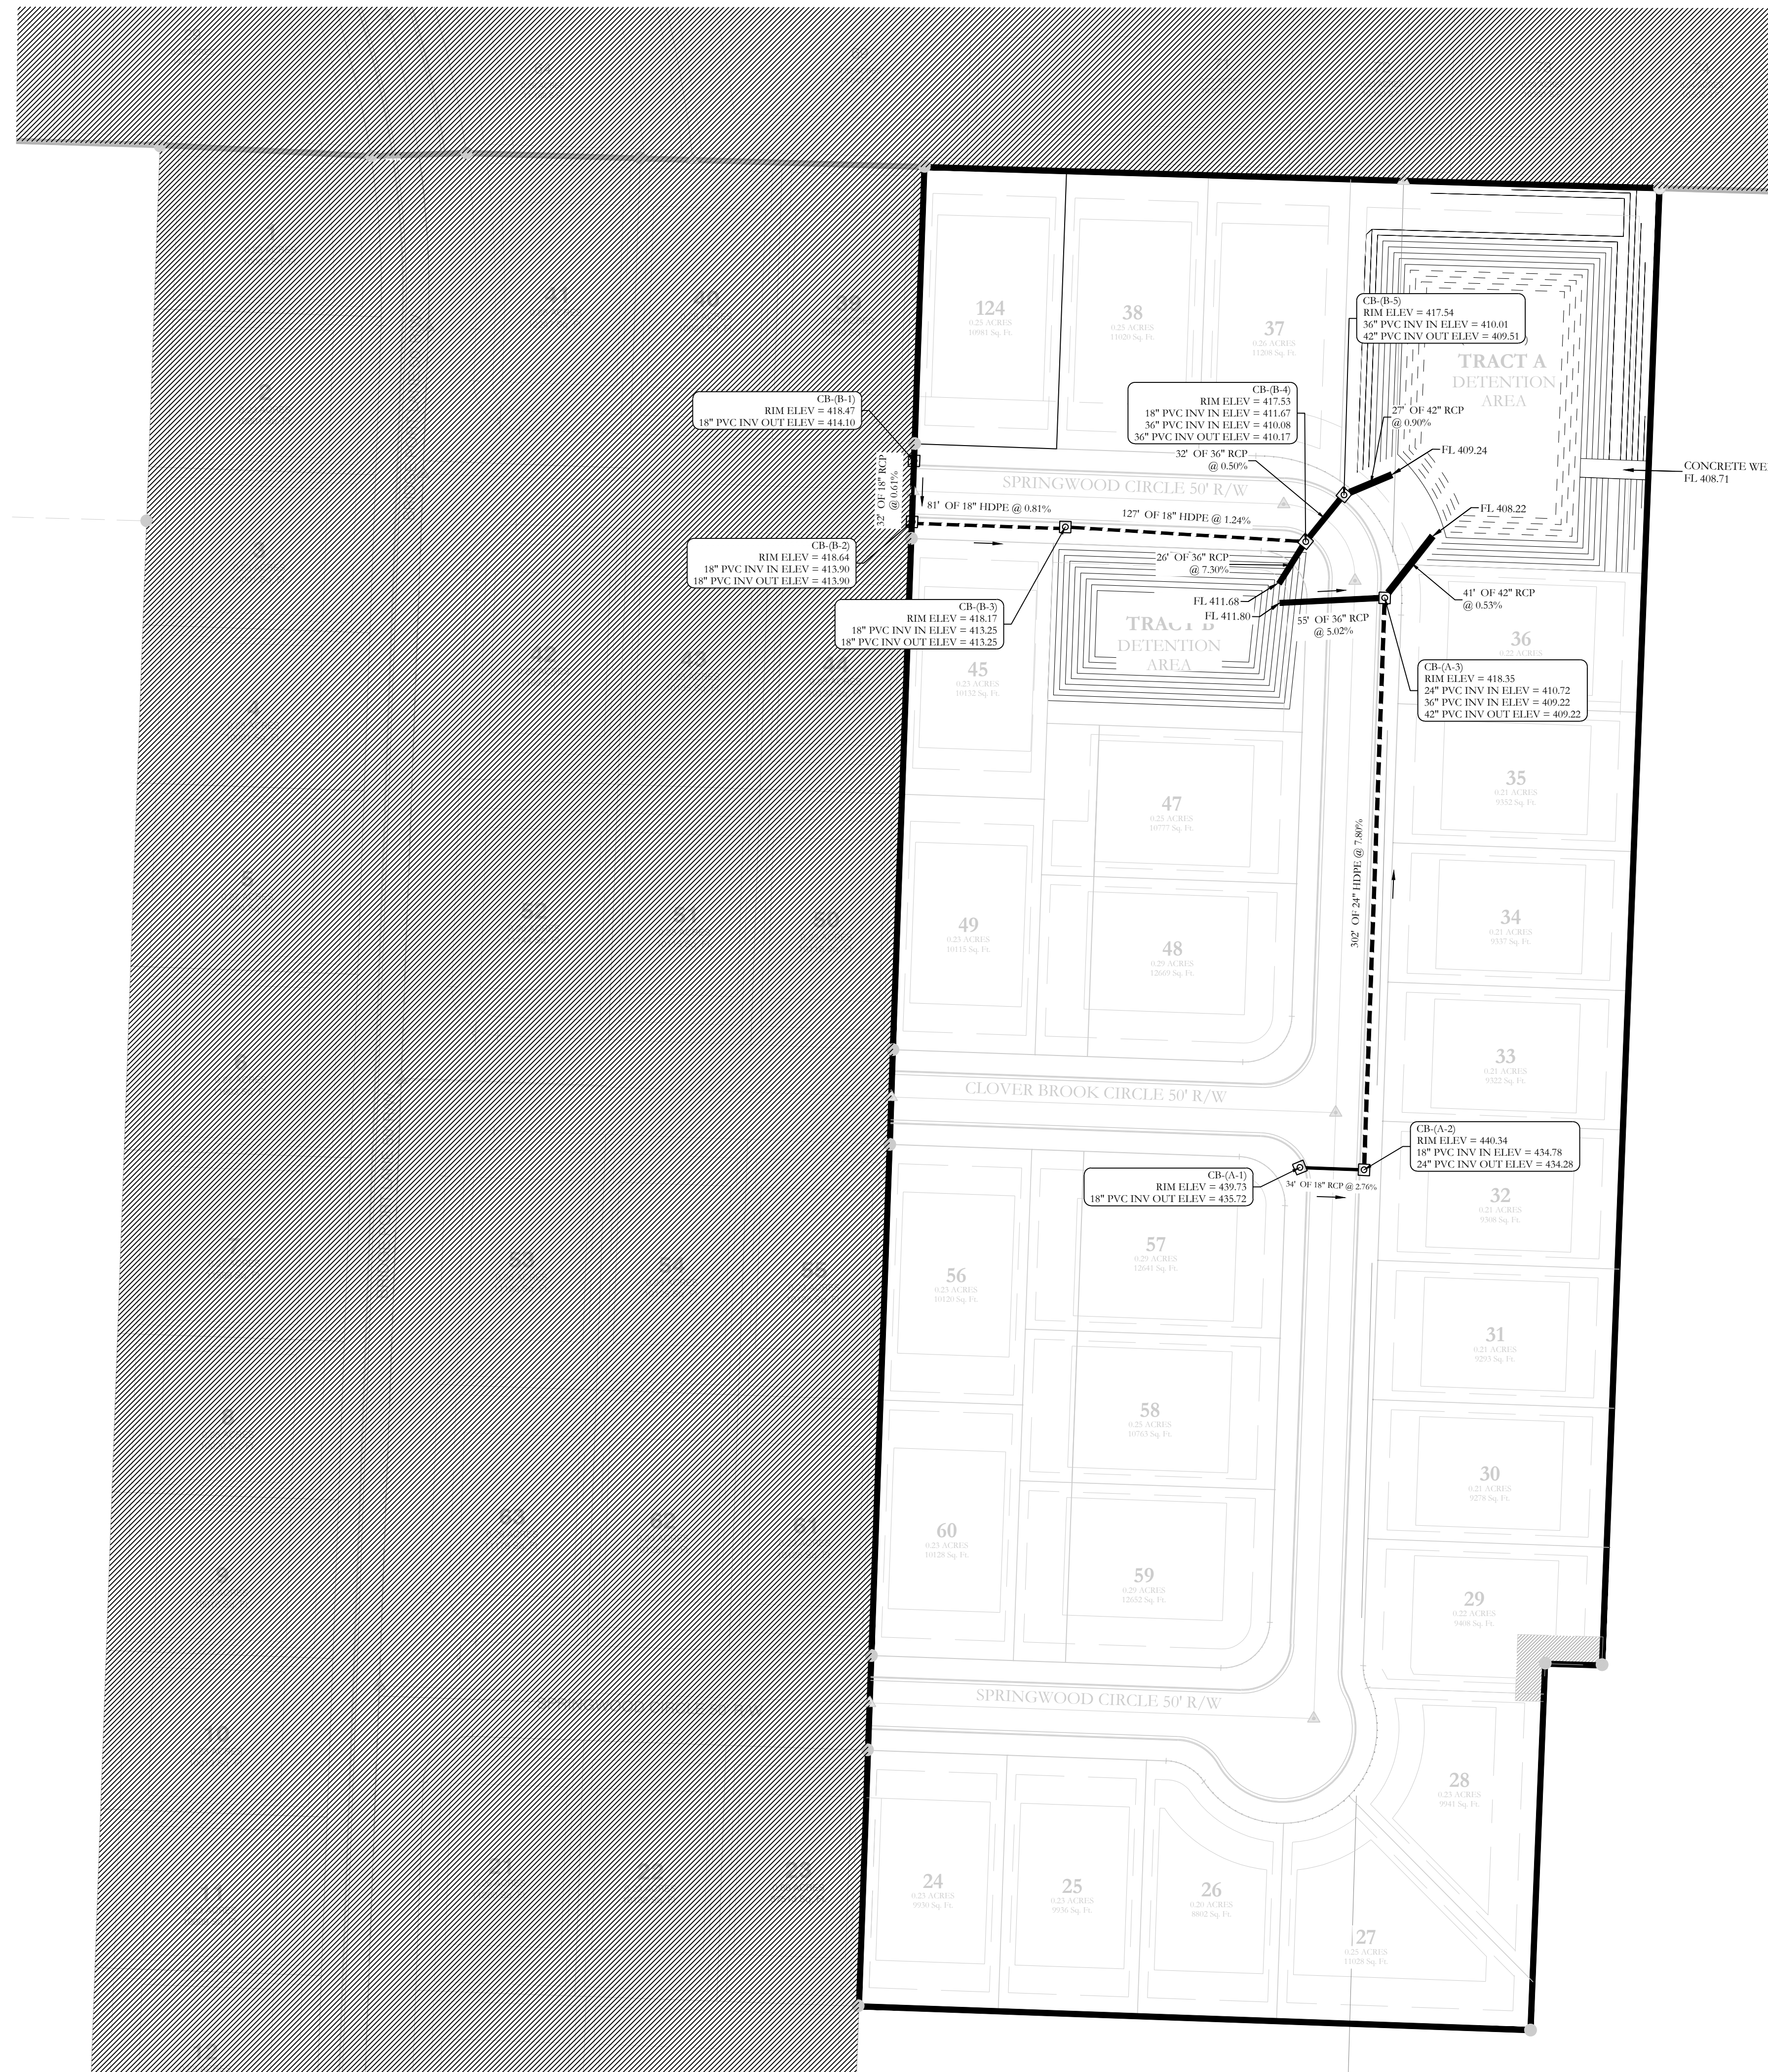

HOPE CONSULTING ENGINEERS - SURVEYORS		129 N. Main Street, Benton, Arkansas 72015 PH. (501)315-2626 FAX (501)315-0024 www.hopeconsulting.com	
FOR USE AND BENEFIT OF: CYPRESS VALLEY			
DRAINAGE AS-BUILTS CYPRESS VALLEY, PHASE 2			
A SUBDIVISION IN THE CITY OF BRYANT, SALINE COUNTY, ARKANSAS			
DATE: 01/17/2023	C.A.D. BY:	DRAWING NUMBER	
REVISED:	CHECKED BY:	21-0421	
SHEET:	SCALE: 1" = 50'		
500	01S	14W	0 10 300 62 1762