


SANITARY SEWER AND WATER AS-BUILTS
HILDALE CROSSING PHASE 2
 A SUBDIVISION IN SALINE COUNTY, ARKANSAS

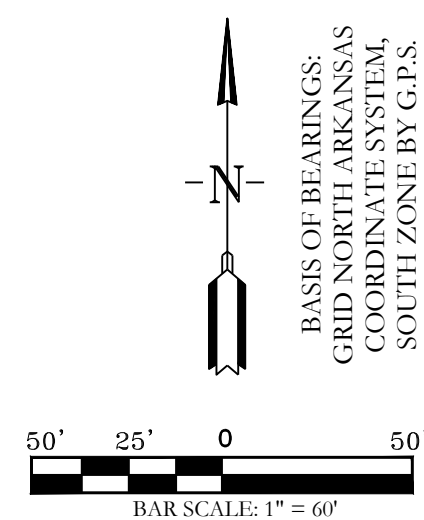

SEWER LEGEND:	WATER LEGEND:	TYPICAL FIRE HYDRANT:
AIR RELEASE VALVE	3" BLOW OFF	3" BLOW OFF
CLEAN OUT	GATE VALVE	REDUCER
ISOLATION VALVE	REDUCER	8"
SEWER SERVICE	WATER LINE	GATE VALVE
SEWER SERVICE	FIRE HYDRANT	8"
	DOUBLE WATER SERVICE	FIRE HYDRANT
	SINGLE WATER SERVICE	

NOTE: PROPOSED SEWER MAINS IS TO HAVE TRACER WIRE. ALSO A NON-BIODEGRADABLE TRENCH ABOVE THE SEWER MAINS.

NOTE: ALL FIRE HYDRANT LEADERS HAVE A GATE VALVE BETWEEN MAIN AND FIRE HYDRANT.



HOPE CONSULTING ENGINEERS - SURVEYORS
 117 S. Market Street, Benton, Arkansas 72015
 PH. (501) 315-2626 FAX (501) 315-0024
 www.hopeconsulting.com

FOR USE AND BENEFIT OF:
 HAVENS DEVELOPMENT, LLC

WATER & SEWER AS-BUILTS PLAN
 HILDALE CROSSING PHASE 2
 A SUBDIVISION IN SALINE COUNTY, ARKANSAS

DATE: 12/20/2021	C.A.D. BY: BJOHNSON	DRAWING NUMBER: 20-0169
REVISED:	CHECKED BY:	SCALE: 1"=50'
500	01S	14W 0 03 330 62 1762