


SANITARY SEWER AND WATER AS-BUILTS
HILLDALE CROSSING PHASE 2
 A SUBDIVISION IN SALINE COUNTY, ARKANSAS

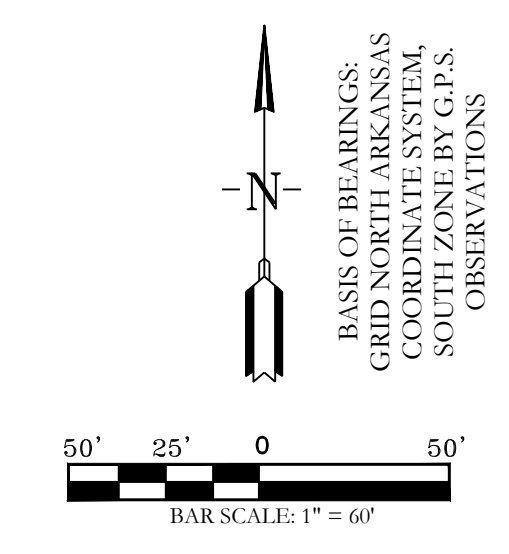

SEWER LEGEND:	WATER LEGEND:	TYPICAL FIRE HYDRANT:
AIR RELEASE VALVE	3" BLOW OFF	3" BLOW OFF
CLEAN OUT	GATE VALVE	REDUCER
ISOLATION VALVE	REDUCER	8"
SEWER SERVICE	WATER LINE	GATE VALVE
SEWER SERVICE	FIRE HYDRANT	FIRE HYDRANT
	DOUBLE WATER SERVICE	
	SINGLE WATER SERVICE	

NOTE: PROPOSED SEWER MAINS IS TO HAVE TRACER WIRE. ALSO A NON-BIODEGRADABLE FIBER OPTIC TRACING THE LINE AS "SEWER" MUST BE INSTALLED IN TRENCH ABOVE THE SEWER MAINS.

NOTE: ALL FIRE HYDRANT LEADERS HAVE A GATE VALVE BETWEEN MAIN AND FIRE HYDRANT.



HOPE CONSULTING ENGINEERS - SURVEYORS

117 S. Market Street,
Benton, Arkansas 72015
PH. (501) 315-2626
FAX (501) 315-0024
www.hopeconsulting.com

FOR USE AND BENEFIT OF:
HAVENS DEVELOPMENT, LLC

WATER & SEWER AS-BUILTS PLAN
HILLDALE CROSSING PHASE 2
A SUBDIVISION IN SALINE COUNTY, ARKANSAS

DATE: 09/27/2023	C.A.D. BY: BJOHNSON	DRAWING NUMBER: 20-0169
REVISIONS:	CHECKED BY:	SCALE: 1"=50'
500	01S 14W 0 03 330 62	1762

L:\PROJECTS\2020\20-0169 HILLDALE CROSSING PHASE 2\AS-BUILT\PHASE 2 AS-BUILT 09-27-2023.DWG