VICINITY MAP:

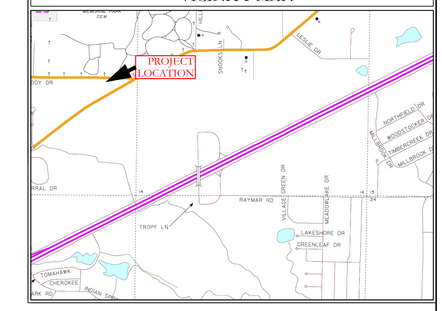

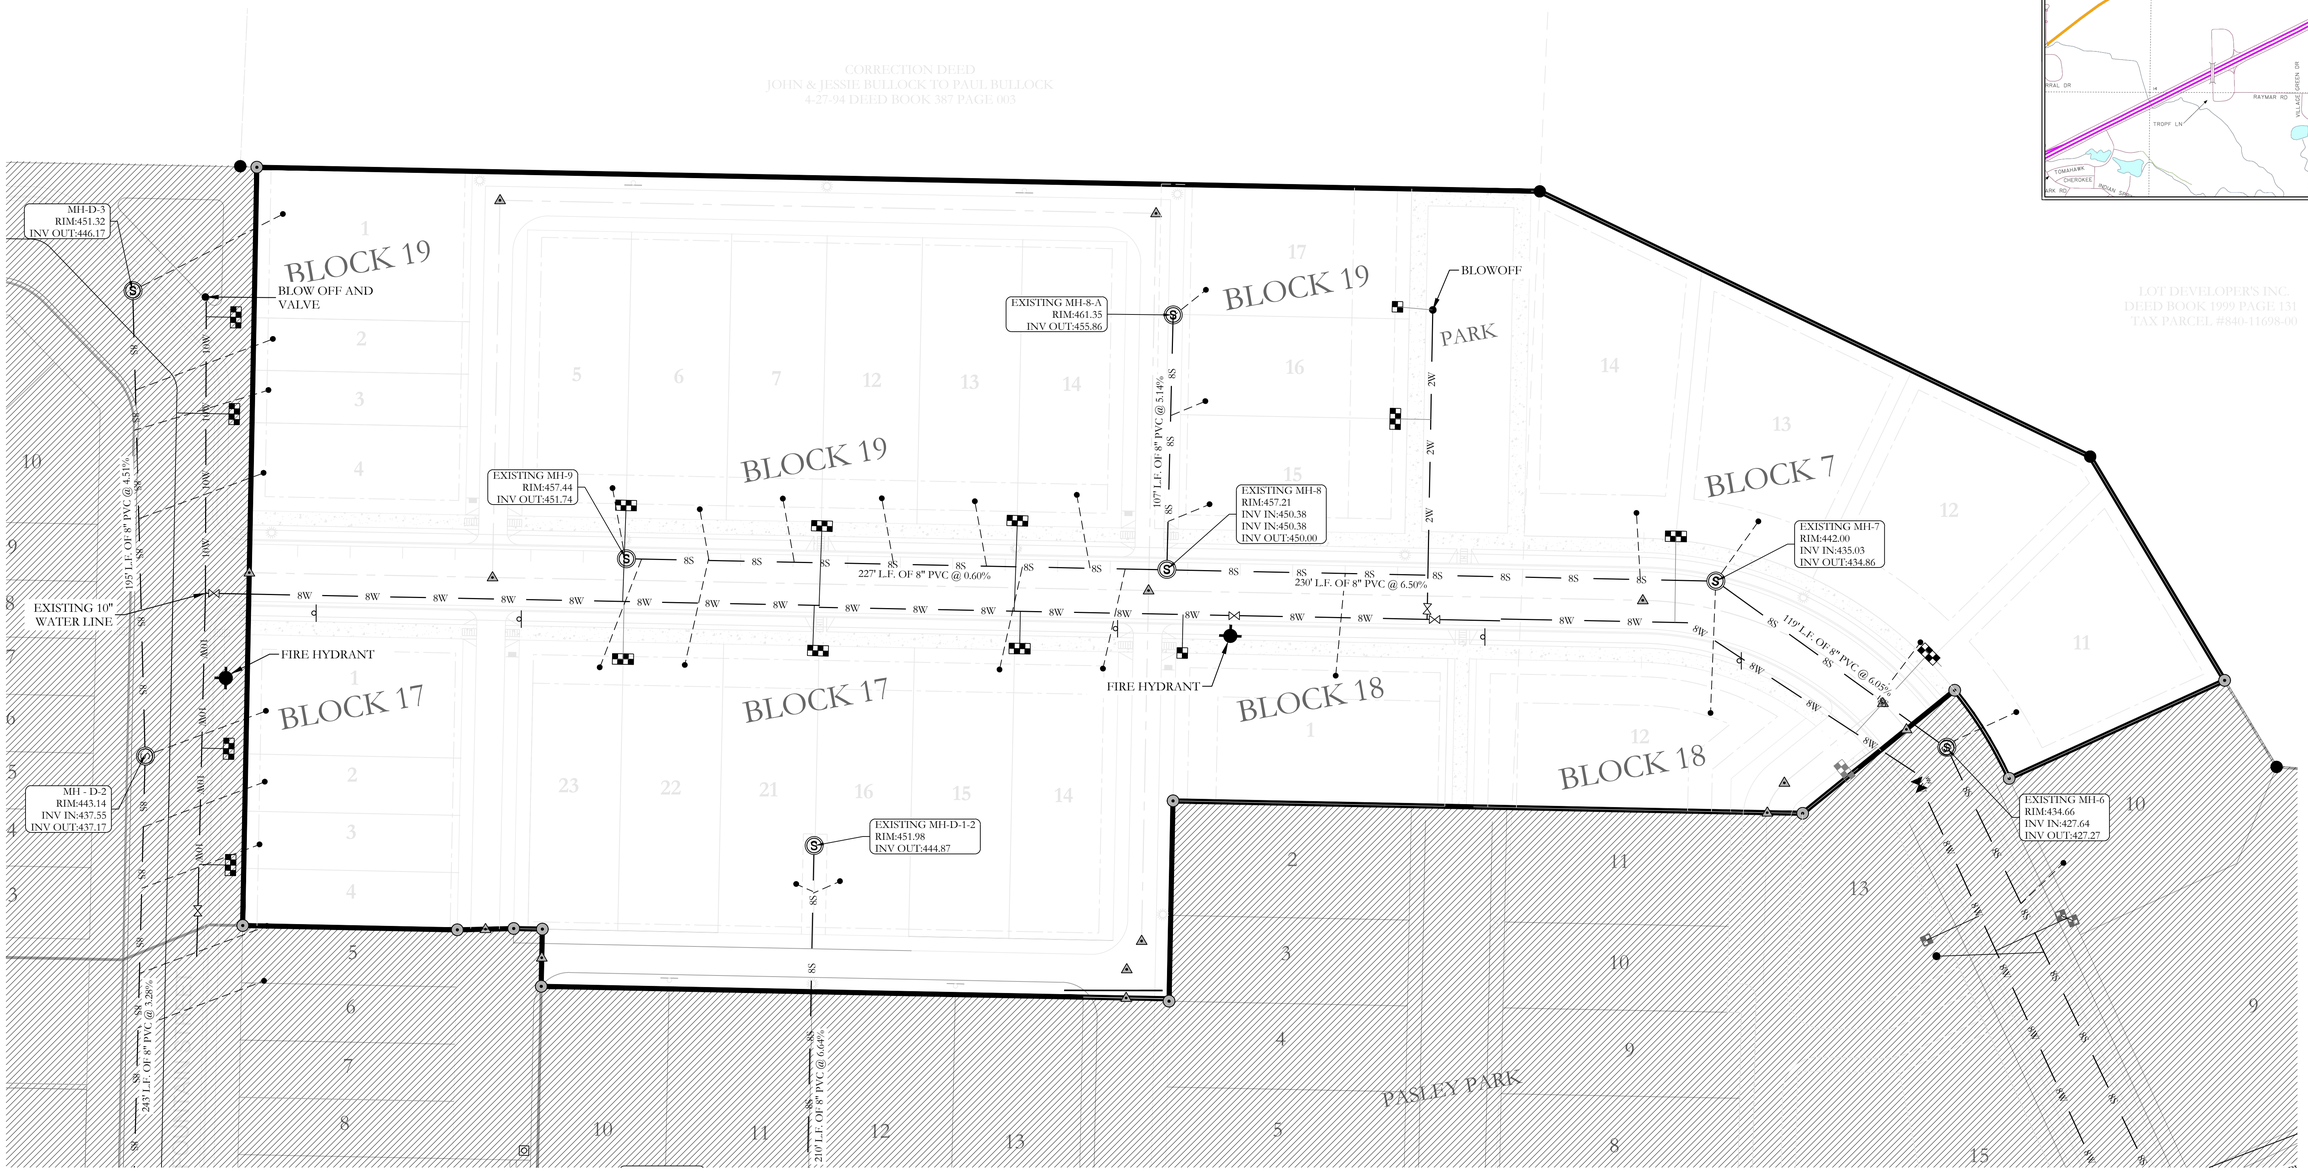

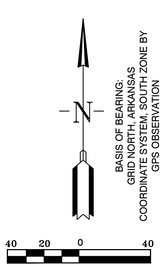

811 Know what's below. Call before you dig.

STATE OF ARKANSAS LICENSED PROFESSIONAL ENGINEER No. 20976 KAZI TAMZIDUL ISLAM

CERTIFICATE OF AUTHORIZATION HOPE CONSULTING, INC. No. 1031 ARKANSAS

SEWER LEGEND:

SEWER SERVICE
SEWER MAIN
SEWER MANHOLE
SERVICE DETAIL

NOTE:
USE SDR-26 PVC SEWER PIPE EXCEPT WHERE DUCTILE IRON PIPE REQUIRED FOR COVER. USE DUCTILE IRON PIPE WHERE 3' MINIMUM COVE CANNOT BE MAINTAINED.
CONTRACTOR IS RESPONSIBLE FOR LOCATING ALL BURIED UTILITIES PRIOR TO CONSTRUCTION.

WATER LEGEND:

DUAL WATER METERS
SINGLE WATER METER
GATE VALVE
45º FITTING
90º FITTING
TEE FITTING
CROSS FITTING
FIRE HYDRANT

HOPE CONSULTING ENGINEERS - SURVEYORS
117 S. Market Street,
Benton, Arkansas 72015
PH. (501)315-2626
FAX (501) 315-0024
www.hopeconsulting.com

FOR USE AND BENEFIT OF:
GRAHAM SMITH CONSTRUCTION, LLC

MIDTOWN BRYANT, PHASE-3
SANITARY SEWER & WATER AS-BUILTS
BRYANT, SALINE COUNTY, ARKANSAS

DATE:	10-02-2024	C.A.D. BY:	DRAWING NUMBER:
REVISED:	11-06-2024	CHECKED BY:	07-0032
SHEET:		SCALE:	

K:\LAND PROJECTS\2004 SUBDIVISIONS\2007\07-0032 MIDTOWN BRYANT, PHASE-3\SANITARY SEWER AS-BUILTS\07-0032 MIDTOWN BRYANT, PHASE-3 SANITARY SEWER AS-BUILTS.DWG
BUILT 10/07/2024 BY: JONES